


T. 11 S., R 6 W. Section 36

RECEIVED

NOV 13 2015

WAVEY RESOURCES DEPT
SALEM, OREGON

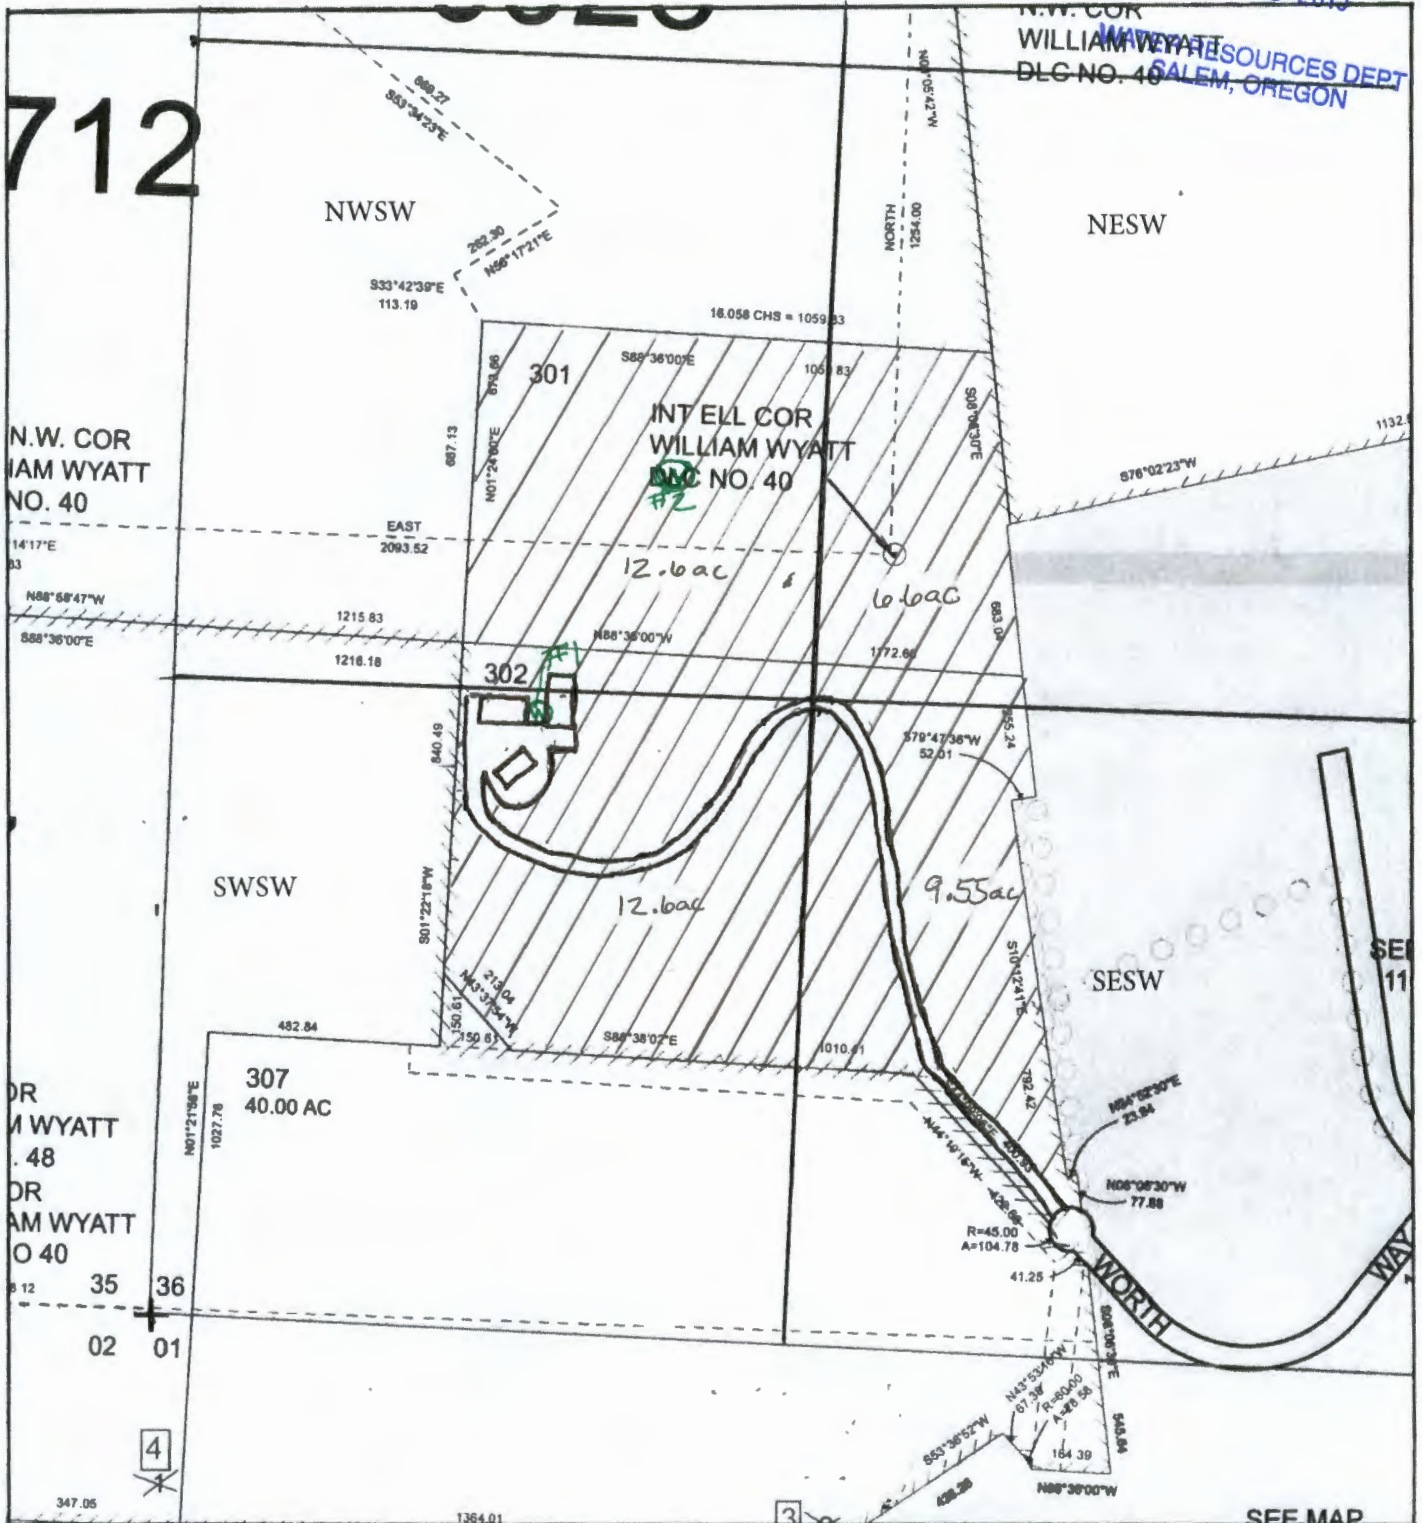

Well #1 1300' N and 760' E
Well #2 1820' N and 1020' E
From SW corner of Sec 36.



1" = 400'

G-18161