


T 9 S. R 1 E. Section 19

RECEIVED
NOV 19 2015
OWRD

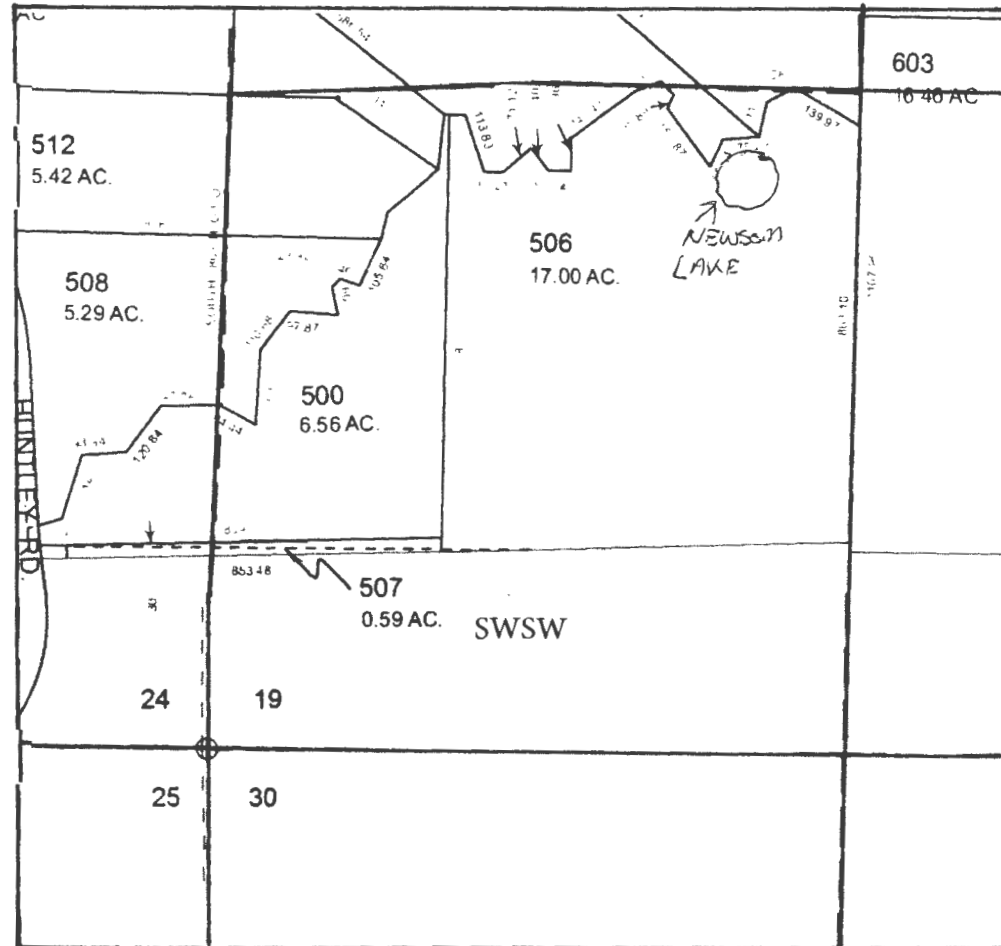

Scale 1" = 400'



Pond is located 1160 feet North and 1040 feet East from the SW corner of section 19.

P.O.D. is located 1280 feet North and 1160 feet East from the SW corner of Section 19

15188-2
R-88157

This map was prepared with the assistance of C.S.G. and is based on information provided by the applicant and by records of the county. This is to represent the location of a water right requested in this application and does not intend to illustrate property boundaries or ownership.