

WELL SURVEY

E. L. NIXON

SECS 2 & 3 T. 14 S. R. 5 W. W.M.


FEB 18-1957

Harold W. Poling
Registered Engr.

SCALE 1"=10 CH.

RECEIVED
AUG 4 1958

STATE ENGINEER
SALEM, OREGON

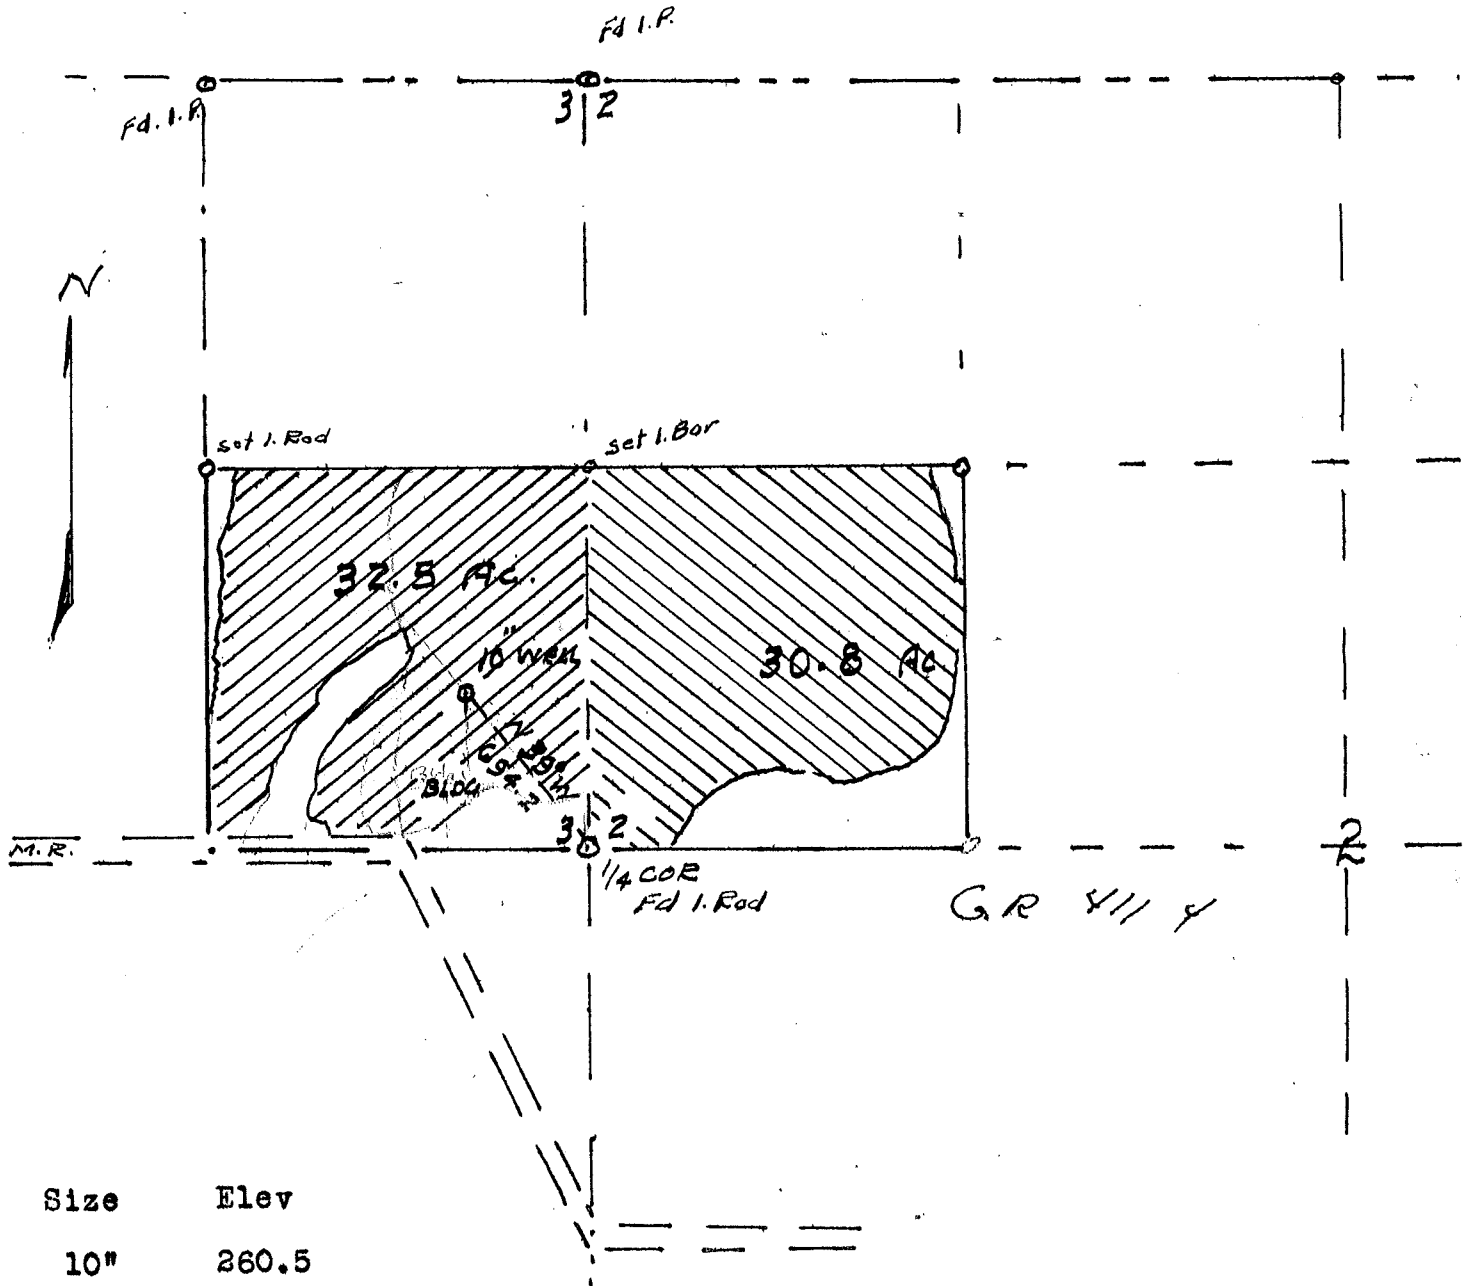

I, Harold W. Poling, a Registered Engineer, do hereby certify that this map was made from notes taken during an actual survey made by me on February 18, 1957; that the monument shown bears N 39 deg W 694.2 ft from the 1/4 corner between Secs. 2 & 3 in T. 14 S. R. 5 W. W.M. Benton County Oregon.

WELL SURVEY

E. L. NIXON

Harold W. Poling


SECS 2 & 3 T. 14 S. R. 5 W. W.M.

FEB 18-1957

SCALE 1"=10 CH.

Harold W. Poling
Registered Engr.

RECEIVED
AUG 1 1958
STATE ENGINEER
SALEM, OREGON

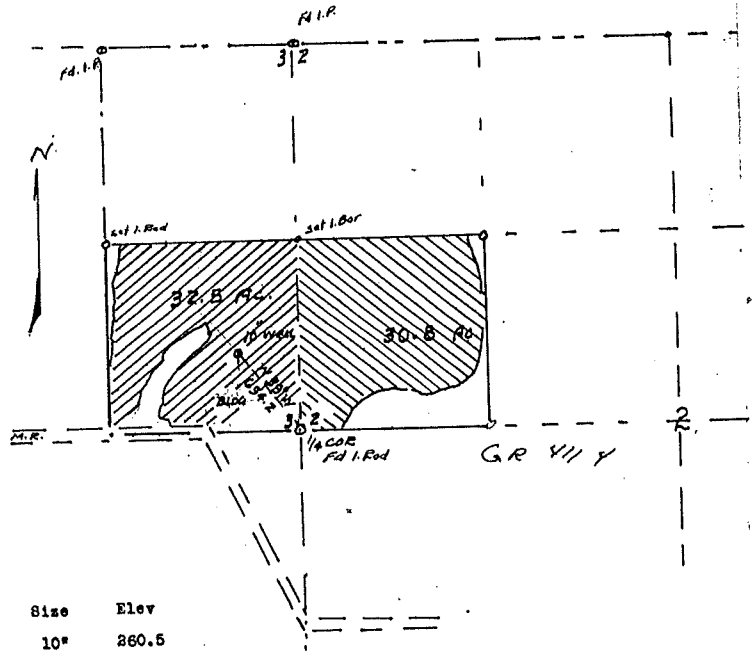

Size	Elev
10"	260.5

I, Harold W. Poling, a Registered Engineer, do hereby certify that this map was made from notes taken during an actual survey made by me on February 18, 1957; that the monument shown bears N 39 deg W 694.2 ft from the 1/4 corner between Secs. 2 & 3 in T. 14 S. R. 5 W. W.M. Benton County Oregon.

Harold W. Poling