

FOR ASSESSMENT AND
TAXATION ONLY

Wells
(1068 + 78133)

SECTION 13 T.19S. R.5W. W.M.
Lane County
1" = 400'

[SW 1/4 of NW 1/4 of Section 13] 19051300

GIS DATA
10/18/2010 10:32:44 AM : ksh/g

CANCELLED:
RECEIVED BY OWRD

DEC 11 2015

SALEM, OR



Distances from
Reference corner:

Well 1068

275 ft. south
38 ft. west

Well 78133

300 ft. South
275 ft. West


Township 19 South
Range 5 West of
Willamette Meridian
NW 1/4 of Section 13
Tax Lot
19 051300 00405

Northeast corner
of property
is the
Reference
Corner

(Approx.
18
acres)

066-03


004-42

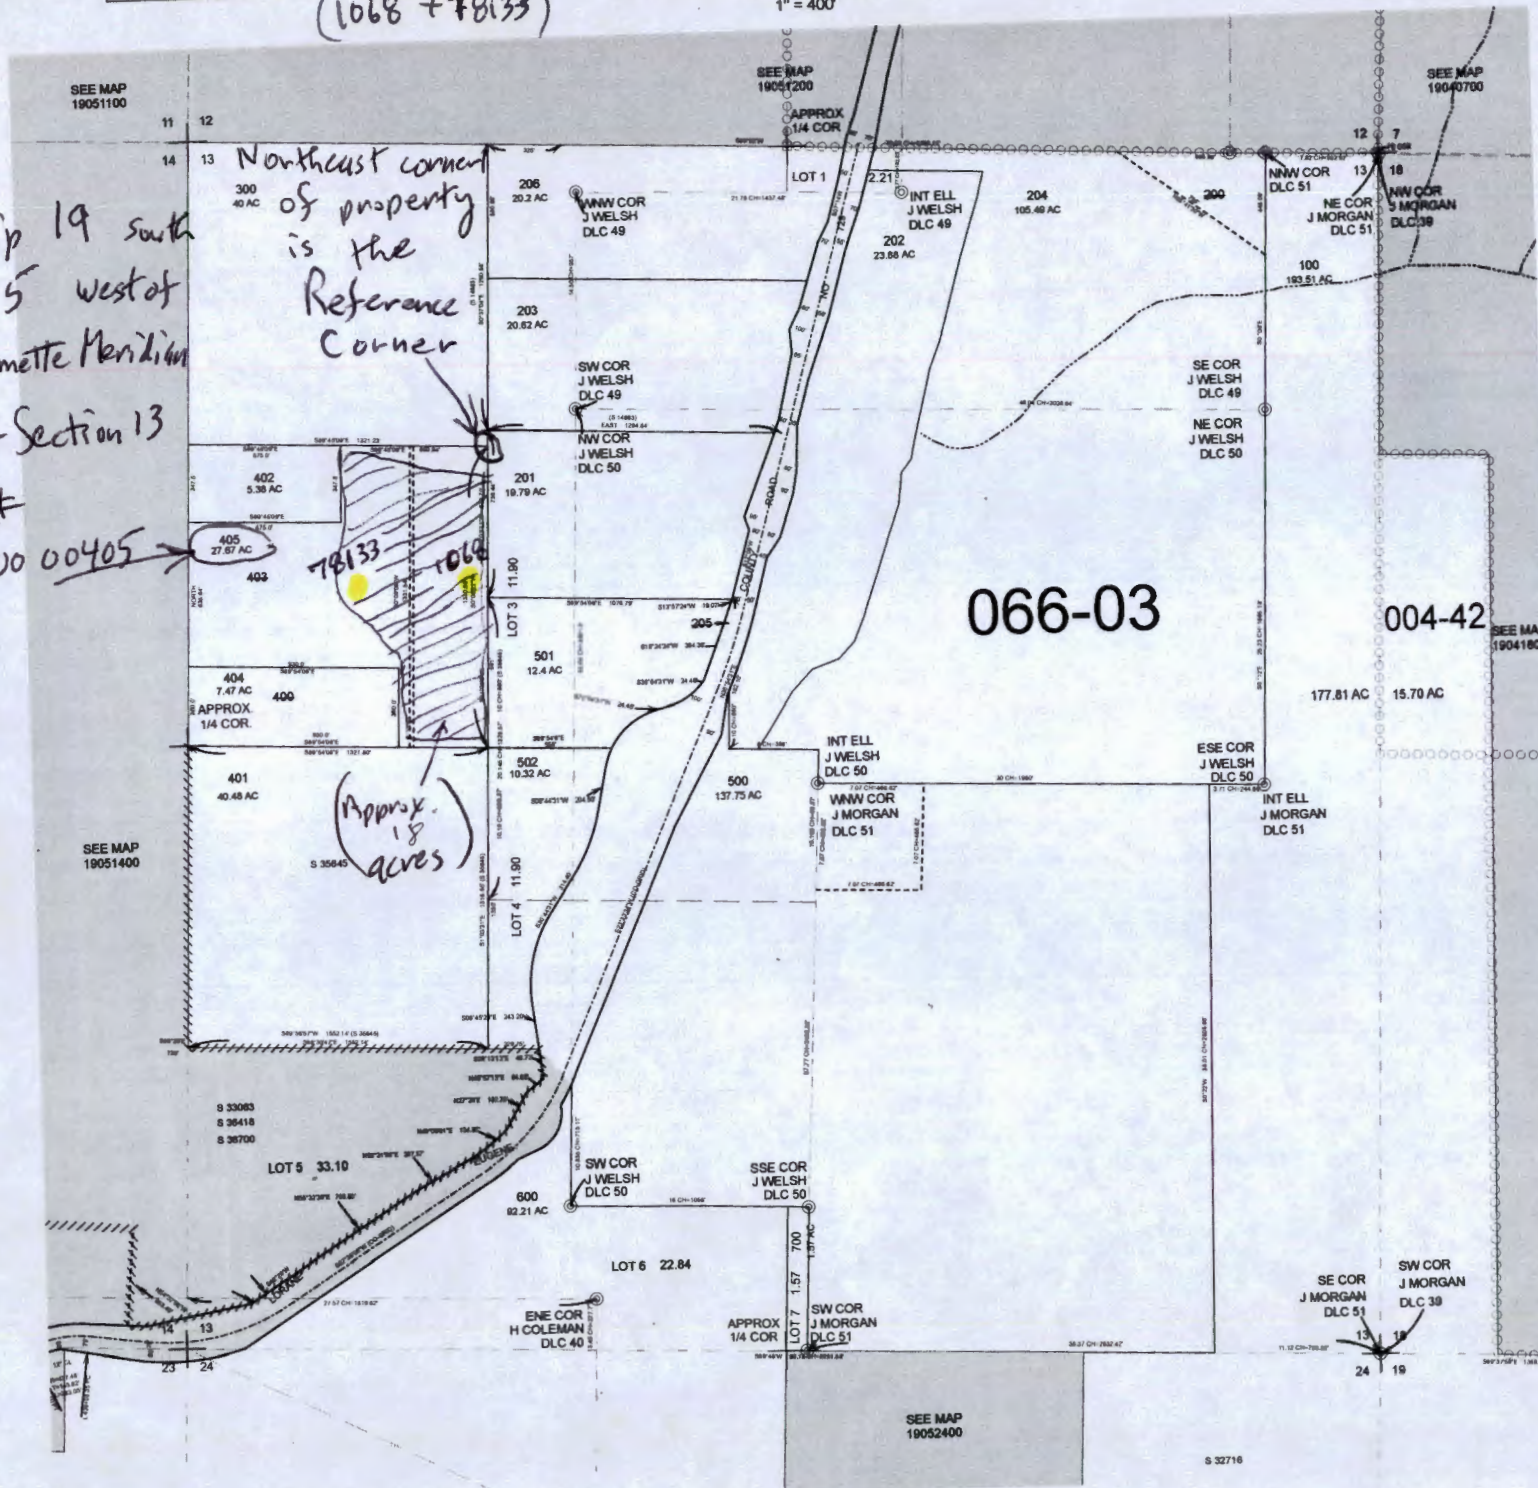

REVISIONS:
6/20/2008 - LCAT 105 - NTL 402 & 403 O.D. 402 NTL 402 O.D. 401
6/20/2008 - LCAT 102 - CONVERT MAP TO GIS
3/26/2008 - LCAT 130 - BEG 401 O.D. 402
10/18/2010 - LCAT 130 - CANC 400 INTO NTL 400 & 403 INTO NTL 403

19051300

18170

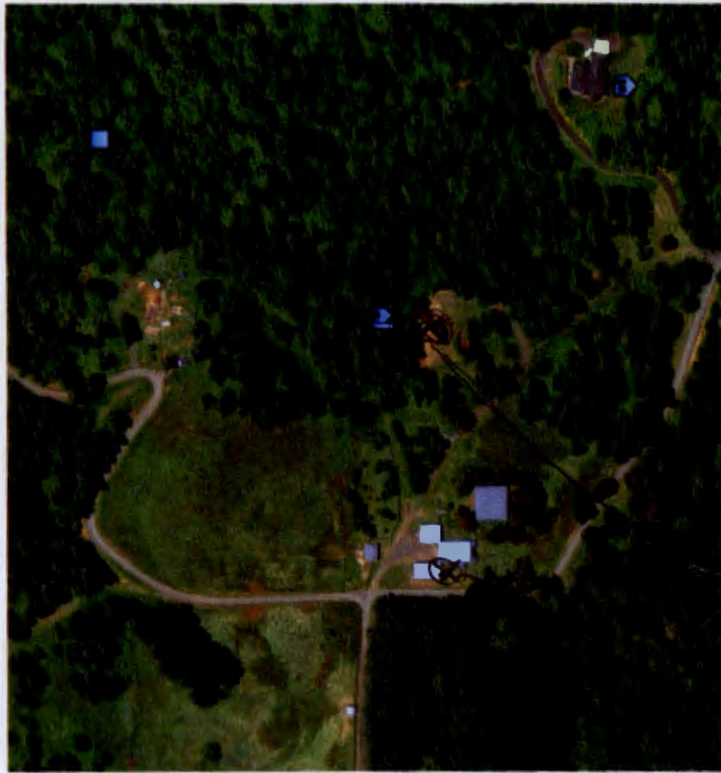

Well 78133

Well 1068

RECEIVED BY OWRD
DEC 11 2015
SALEM, OR

A 18170