


T35S R6W NE Quarter Section 29

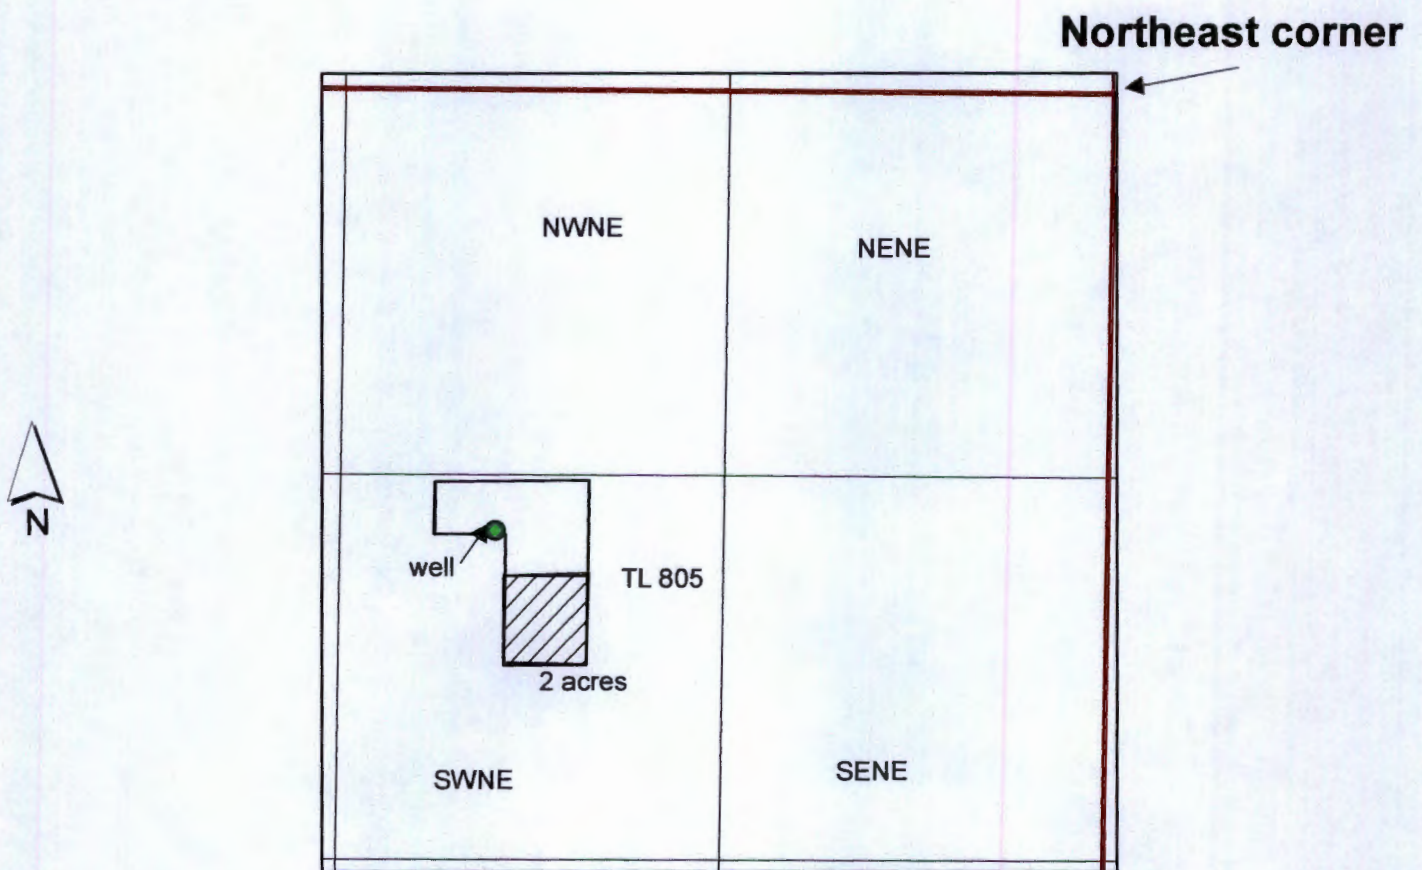

1 inch = 660 feet

**Well is located 1512 feet south
and 2113 feet west from the NE corner**

RECEIVED BY OWRD

DEC 15 2015

SALEM, OR

G-19074