


T35S R6 Northeast Section 9

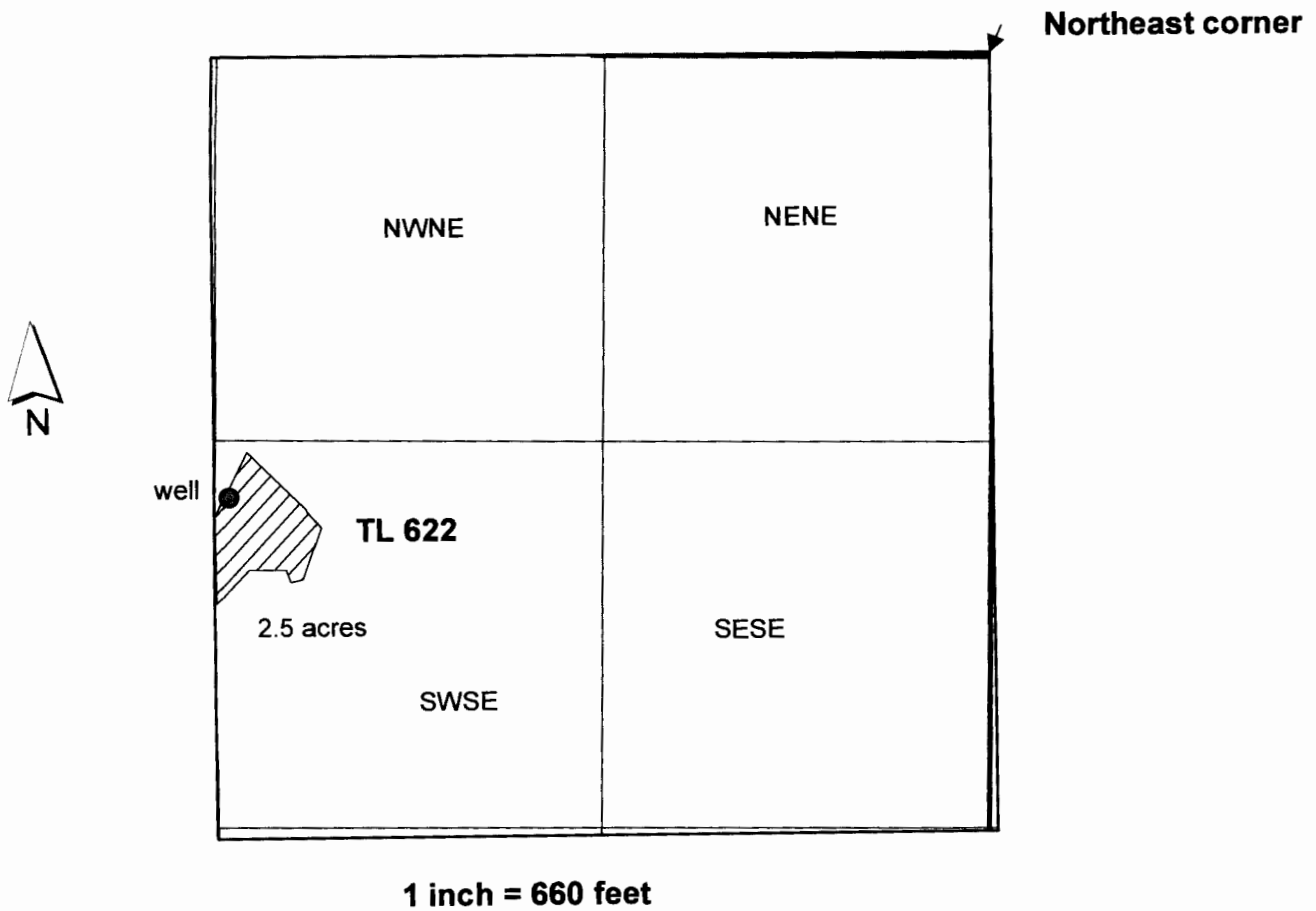

Well location lat/long: 42.54546/-123.41589


RECEIVED BY OWRD

JAN 04 2016

SALEM, OR

6-18189

T35S R6 Northeast Section 9

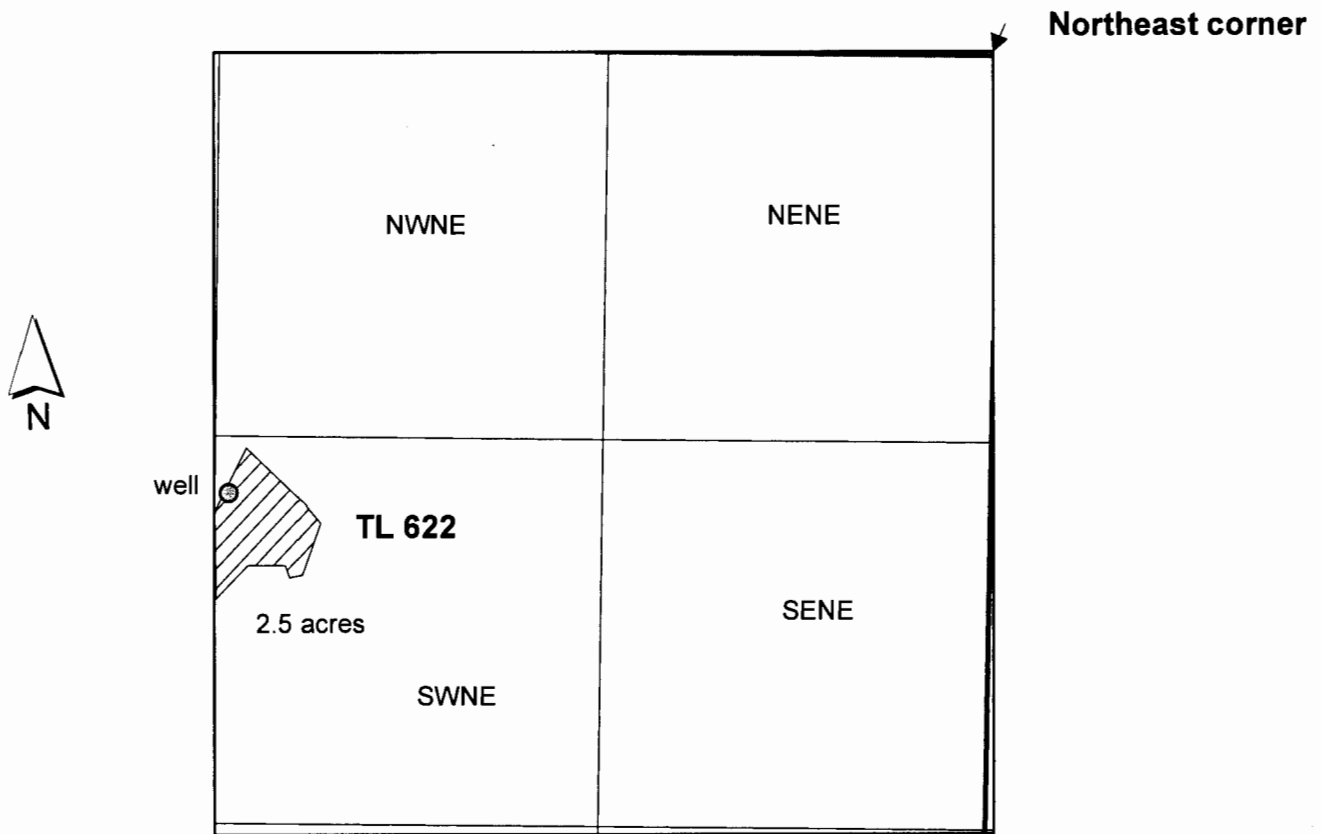

1 inch = 660 feet

The well is located 1507 feet south and 2613 ft west from the northeast corner Section 9.

RECEIVED

JAN 05 2016

WATER RESOURCES DEPT
SALEM, OREGON

6-18189