


T39S R5W Northwest Section 9

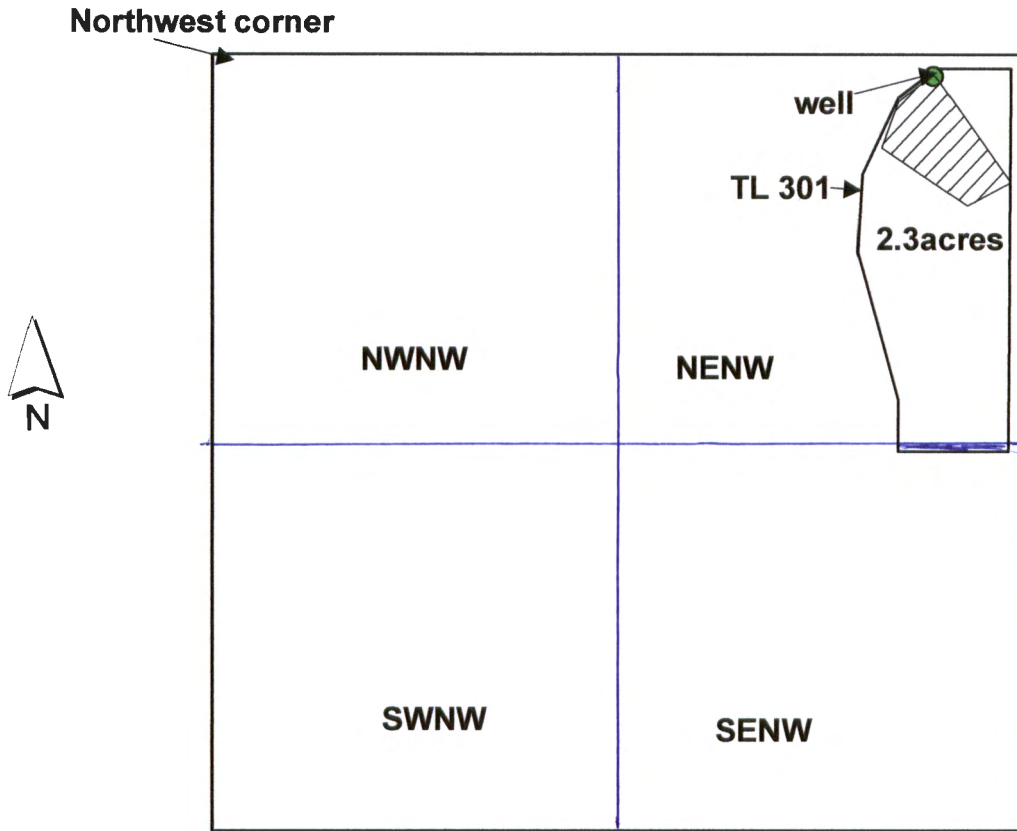

1 inch = 660 feet

The well is located 58 feet south and 2379 feet east from the northwest corner.

RECEIVED BY OWRD

JAN 04 2016

SALEM, OR

G1-10107