


**T36S R6W South half Northwest and  
North half Southwest Section 32**

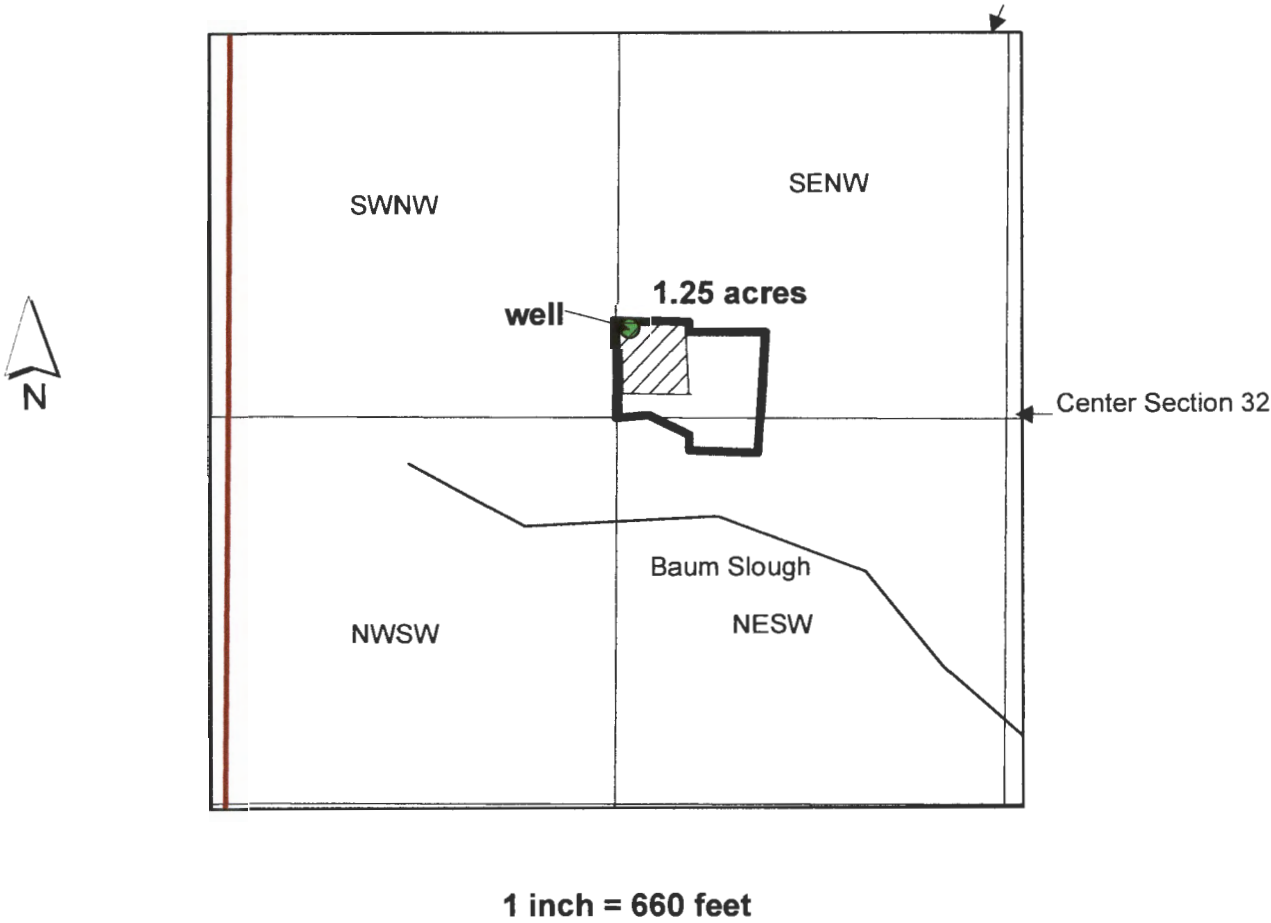

The well is located 1263 ft west and 310 ft north from the center of Section 32.

RECEIVED BY OWRD

JAN 04 2016

SALEM, OR

G-19189