


T 17 S., R 2 W.,
Section 3

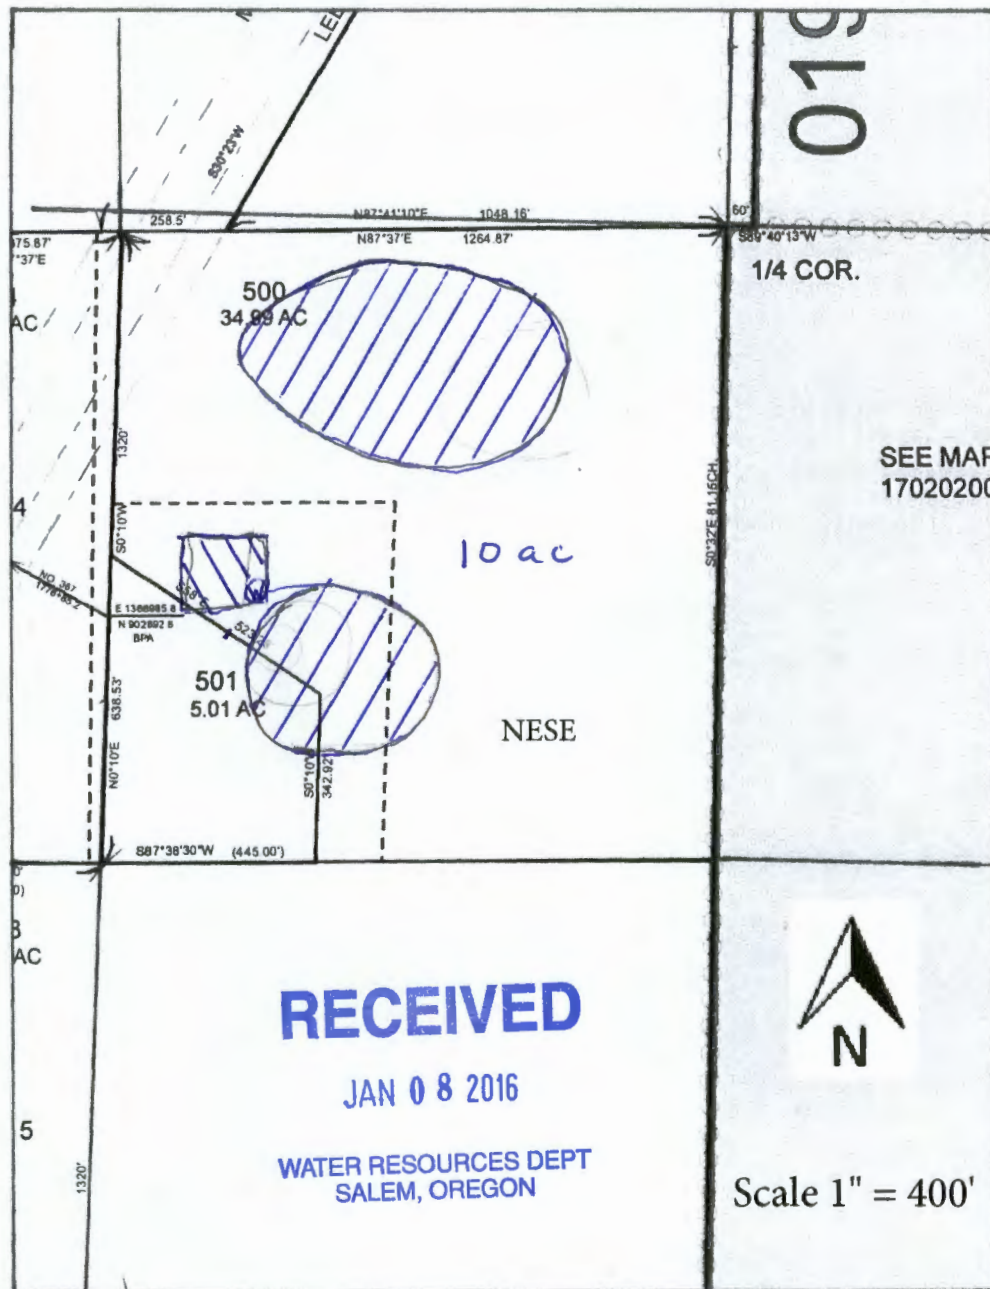

Well is locate 960 feet West and 760 feet South
from the East 1/4 corner of section 3

**STATE OF OREGON
WELL LOCATION MAP**

This map is supplemental to the WATER SUPPLY WELL REPORT

Oregon Water Resources Department

725 Summer St NE, Salem OR 97301
(503)986-0900



LOCATION OF WELL

Latitude: 44.1187968367 Datum: WGS84

Longitude: -122.9098363171

Township/Range/Section/Quarter-Quarter Section:

WM 17S 2W 3 NESE

Address of Well:

90331 SUNDERMAN RD
SPRINGFIELD

RECEIVED

JAN 08 2016

**WATER RESOURCES DEPT
SALEM, OREGON**


Well Label: L117283

Well Log: LANE 73698

Printed: April 20, 2015

DISCLAIMER: This map is intended to represent the approximate location of the exempt use well provided by the land owner. It is not intended to be construed as survey accurate in any manner.

Generated by OWRD

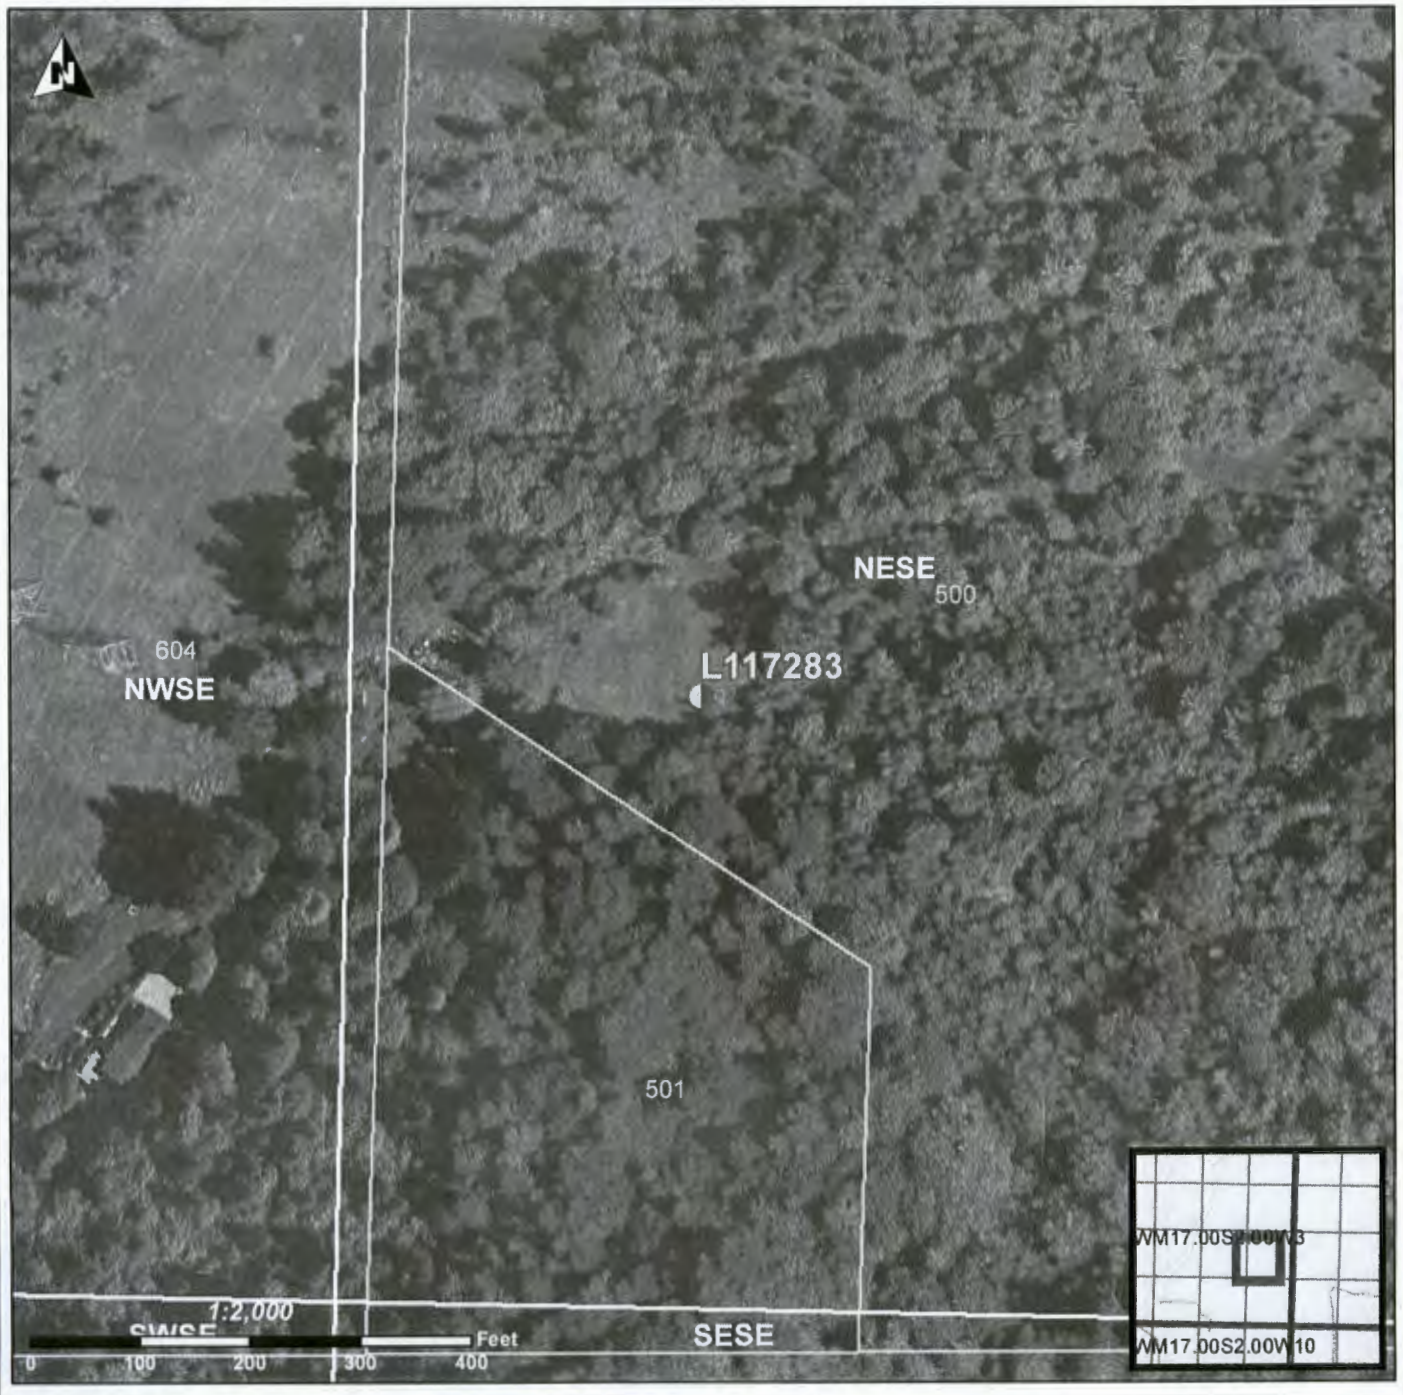

G-10226