


RECEIVED

SCALE 1"

JAN - 4 1995

34

WATER RESOURCES DEPT.
SALEM, OREGON

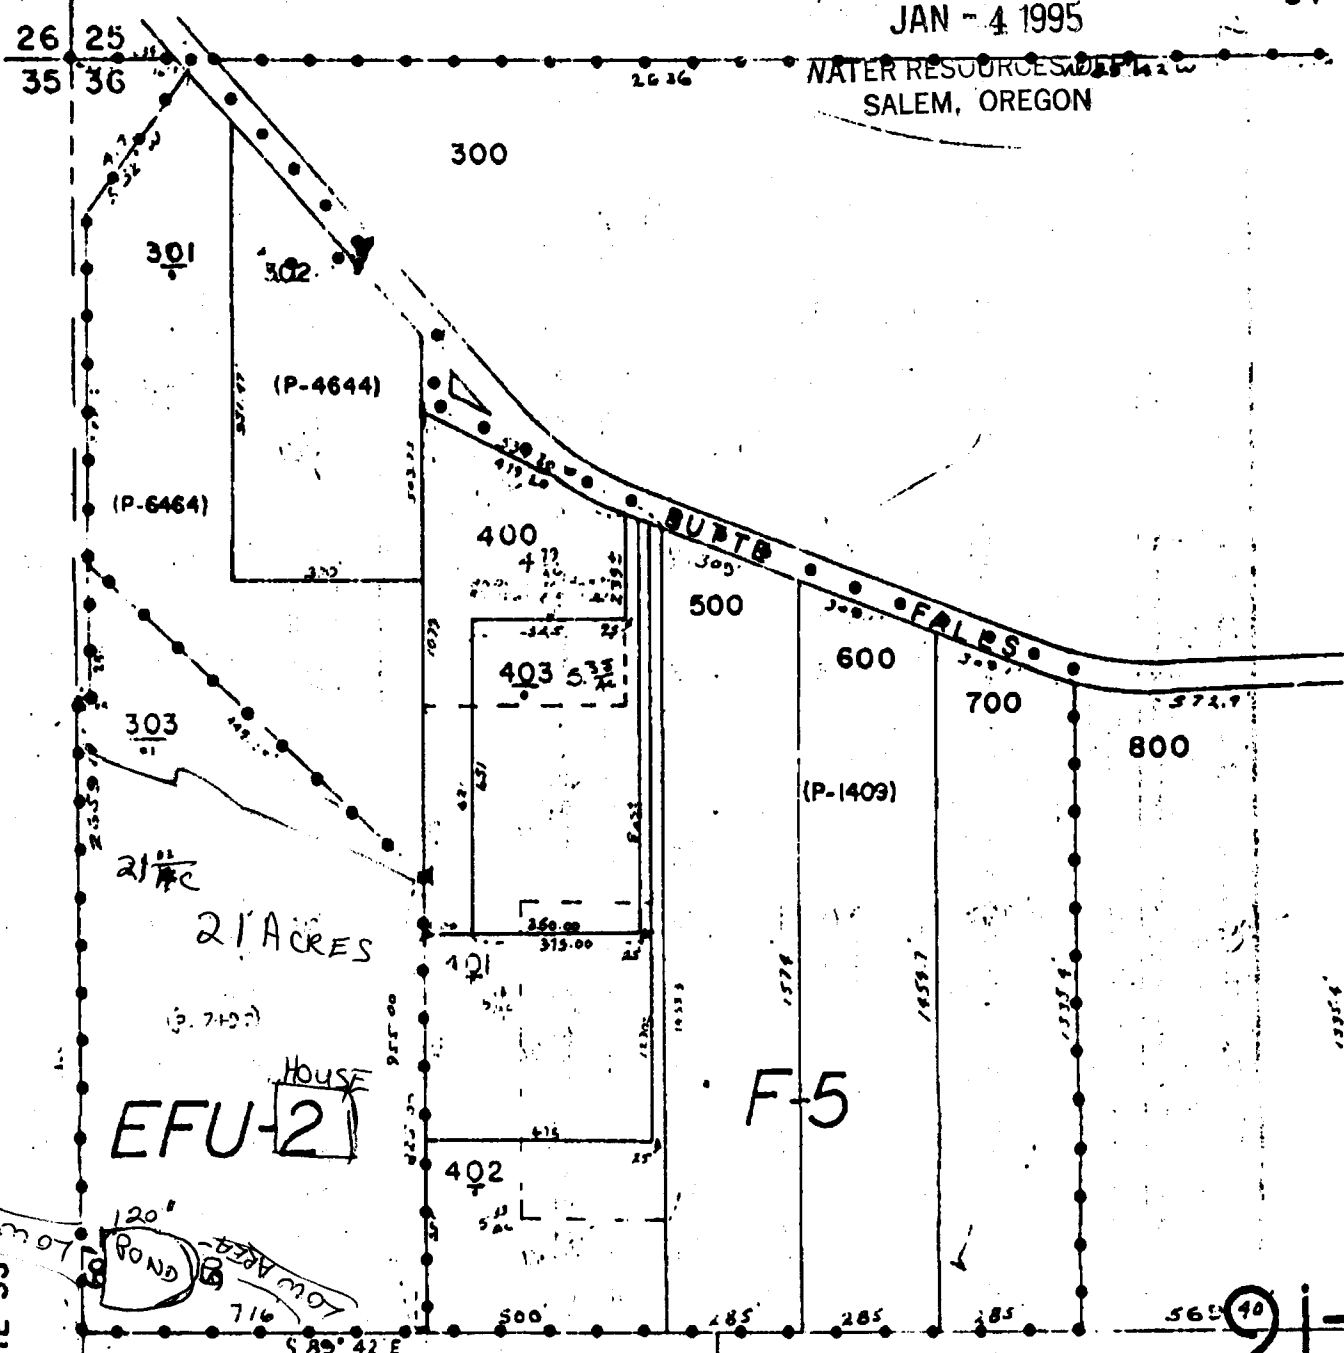

EFU-2


F-5

1100

1200

1101

1102

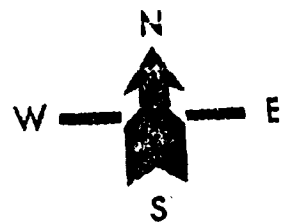

AMERICAN PACIFIC
TITLE & ESCROW COMPANY
Prestige Plaza Bldg., Suite A
100 Main Street East
Medford, Oregon 97501

Application No. *P-79996*
Permit No.

THIS MAP IS PROVIDED SOLELY FOR THE PURPOSE OF ASSISTING IN THE LOCATION OF THE PROPERTY. THE COMPANY ASSUMES NO LIABILITY FOR VARIATIONS, IF ANY, IN DIMENSIONS OR LOCATIONS ASCERTAINED BY AN INDIVIDUAL.