


LOYSA'S CURRENT LEASE INFORMATION ON CLATSOP COUNTY LAND:

BLOCK 32 & 33 SEE PAGE 9
BLOCK 34 & 25 SEE PAGE 10

AREA A
AREA A

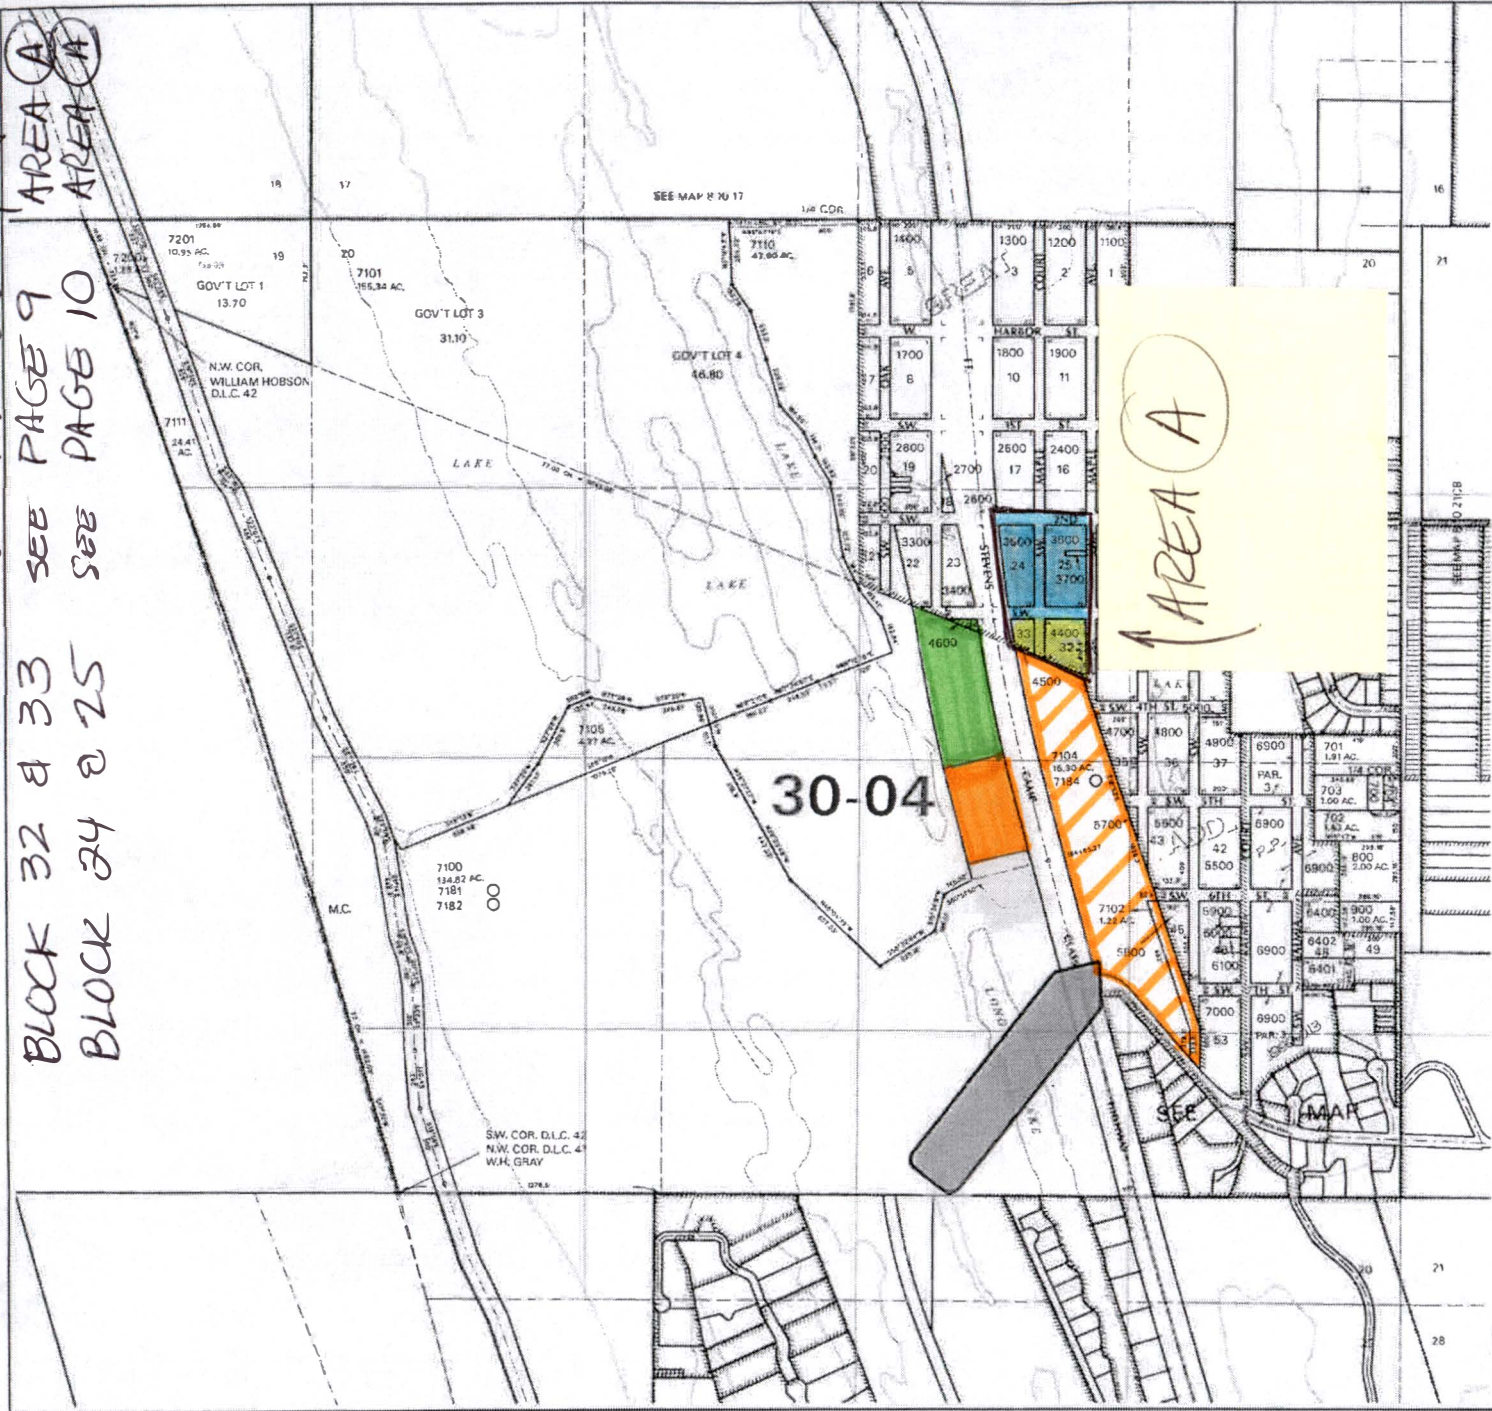

T8N R10W SEC 20 WM
CLATSOP COUNTY
Scale 1:4800
NAD 1983/97 HARN StatePlane Oregon North, FIPS 3501, NAD 1983

RECEIVED BY OWRD

FEB 03 2016


SALEM, OR

Canceled Accounts

- 101
- 102
30-04

AREA A

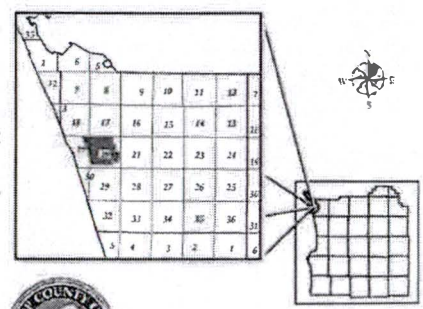

This map was prepared for the assessment of the Clatsop County land. The data is provided by Clatsop County, to support its government activities. Clatsop County is not responsible for any errors, omissions, or misinterpretations.

October 07, 2015

8.10.20

618254

Map

RECEIVED BY OWRD

FEB 03 2016



Clatsop County Webmaps

Disclaimer: This map was produced using Clatsop County GIS data. The GIS data is maintained by the County to support its governmental activities. This map should not be used for survey or engineering purposes. The County is not responsible for map errors, omissions, misuse or misinterpretation. Photos may not align with taxlots.





6-0254

T8N R10W SEC 20 WM CLATSOP COUNTY

Scale 1" = 400'

1600 ft

NAD 1983/91 HARN StatePlane Oregon North FIPS 3601 Int'l Feet

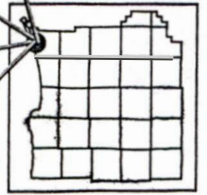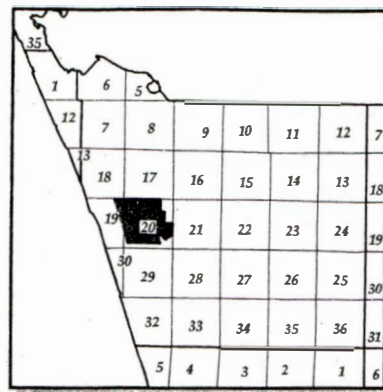


This map was produced for assessment purposes only using Clatsop County data. The data is maintained by Clatsop County to support its governmental activities. Clatsop County is not responsible for any map errors, possible omissions, or missing information.

November 10, 2015

WARRENTON

8.10.20

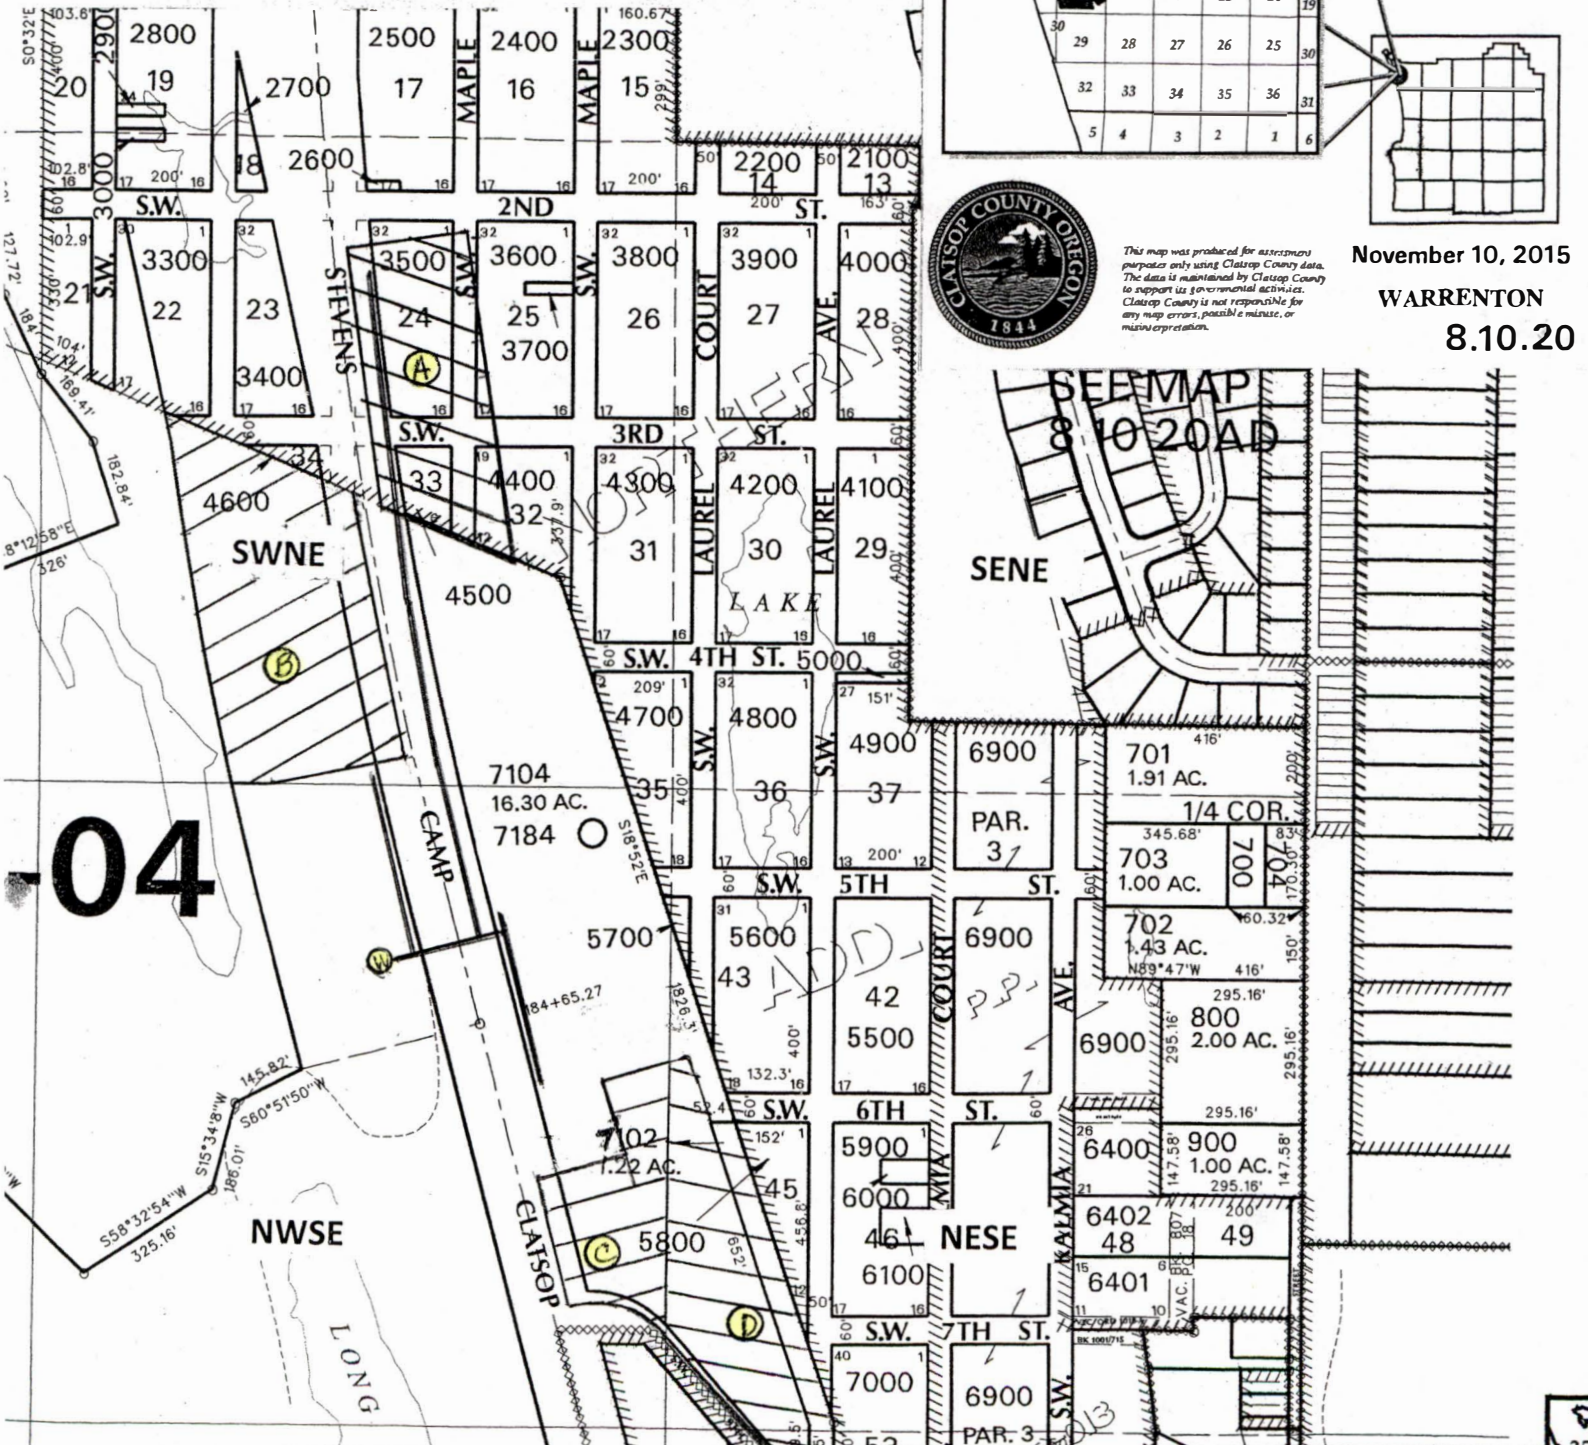

Area (A) 3.6 acres. Field 4 and part of Field 2.

Area (B) 4.1 acres. Potential growth area.

Area (C) 2.6 acres. Potential growth area.

Area (D) 3.8 acres. Potential growth area.

Well (W) Located approximately 1940 feet east and 260 feet south from the eastern 1/4 corner of section 20.

3" PVC water pipes from well (W) are noted.

RECEIVED BY OWRD

FEB 03 2016

SALEM, OR

G-10254