

















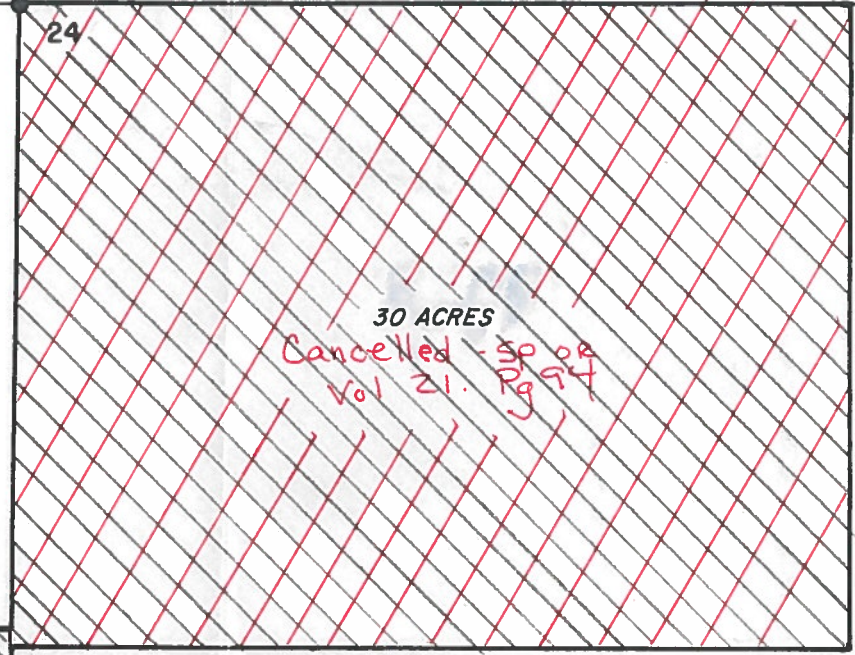

NW 1/4 OF NW 1/4

This map prepared by the department  
to represent the remaining portion of  
cert 3222 that was not canceled  
by SP or Vol 21 pg 94. JP  
24-FEB-16

REGISTERED  
OREGON  
LAND SURVEYOR

*Ralph G. Barnes*

MAY 5, 1950  
RALPH G. BARNES  
263

RECEIVED  
MAY 19 1950  
STATE ENGINEER  
SALMON, OREGON

Application No. G-2349  
Permit No. G-2224