


T38S R5W Southwest Quarter Section 14

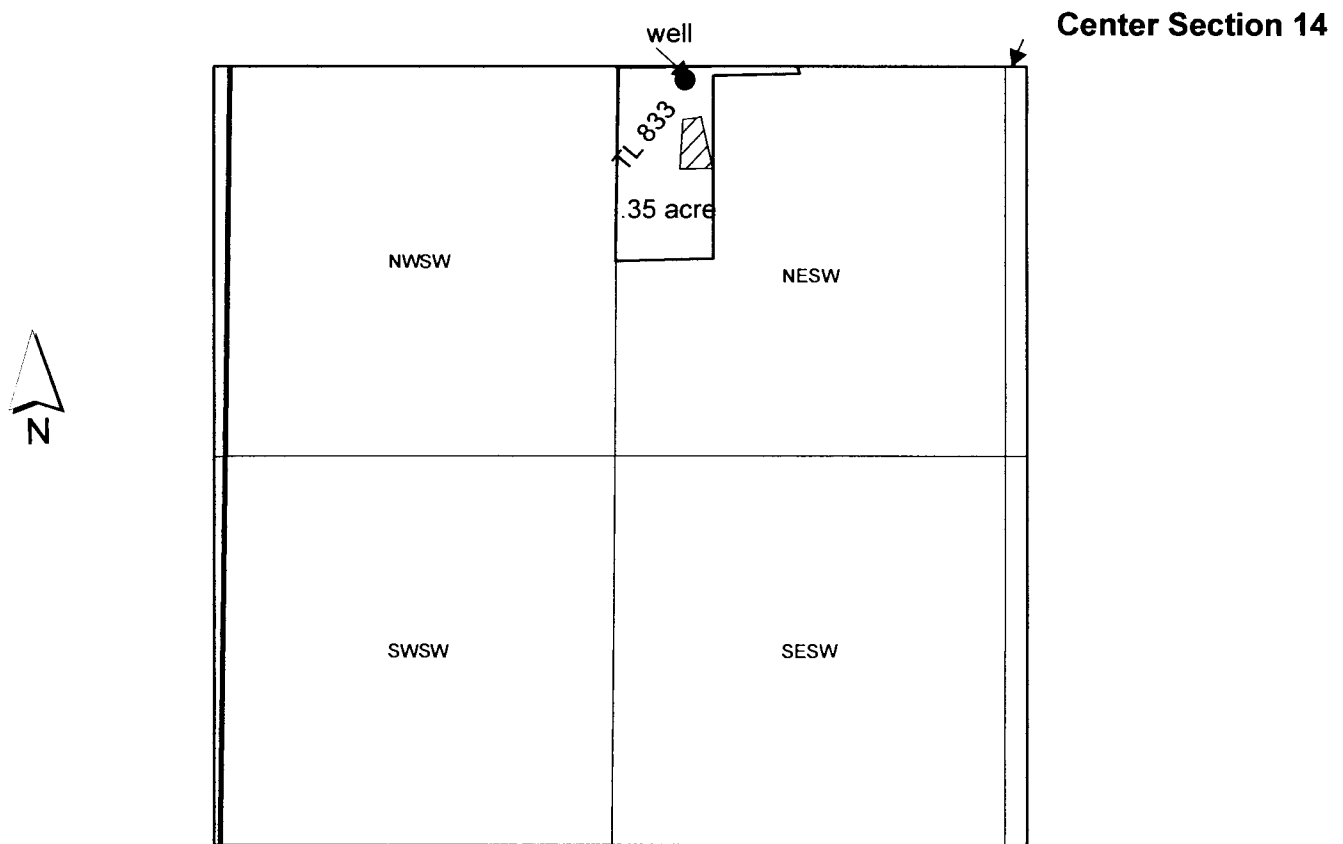

1 inch = 660 feet

The well is approximately 41 ft south and 1094 ft west from the center of Section 14, according to property owner.

RECEIVED BY OWRD

JAN 19 2016

SALEM, OR

G-18235