



TS 39-7W-31 TL 201 NENW

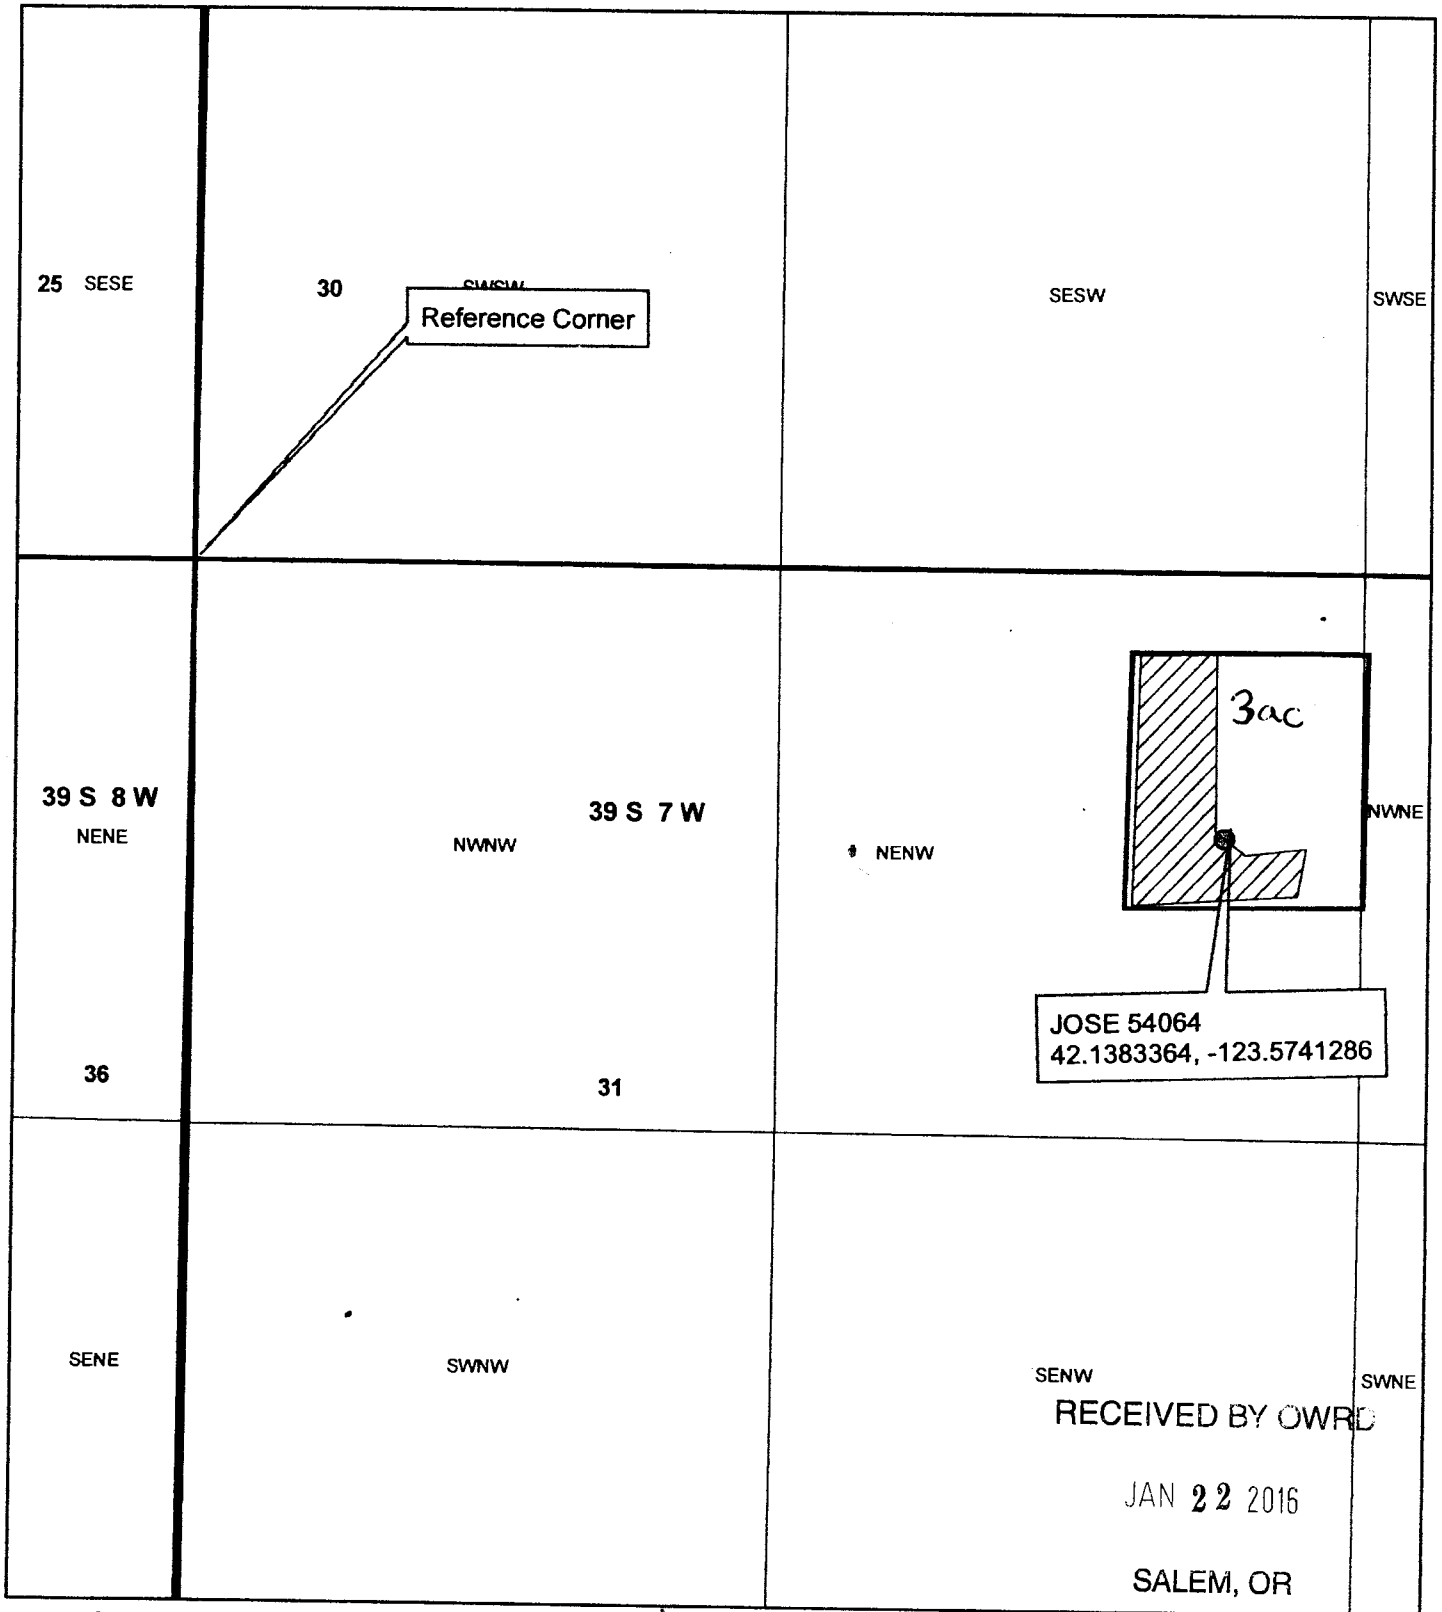

Legend

- TL 201
- Townships
- Sections

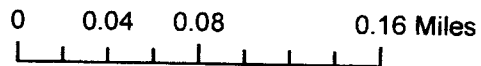


Well (JOSE 54064) is
2363 ft East and
634 ft South of NW Corner
of Section 31



Gr-15257

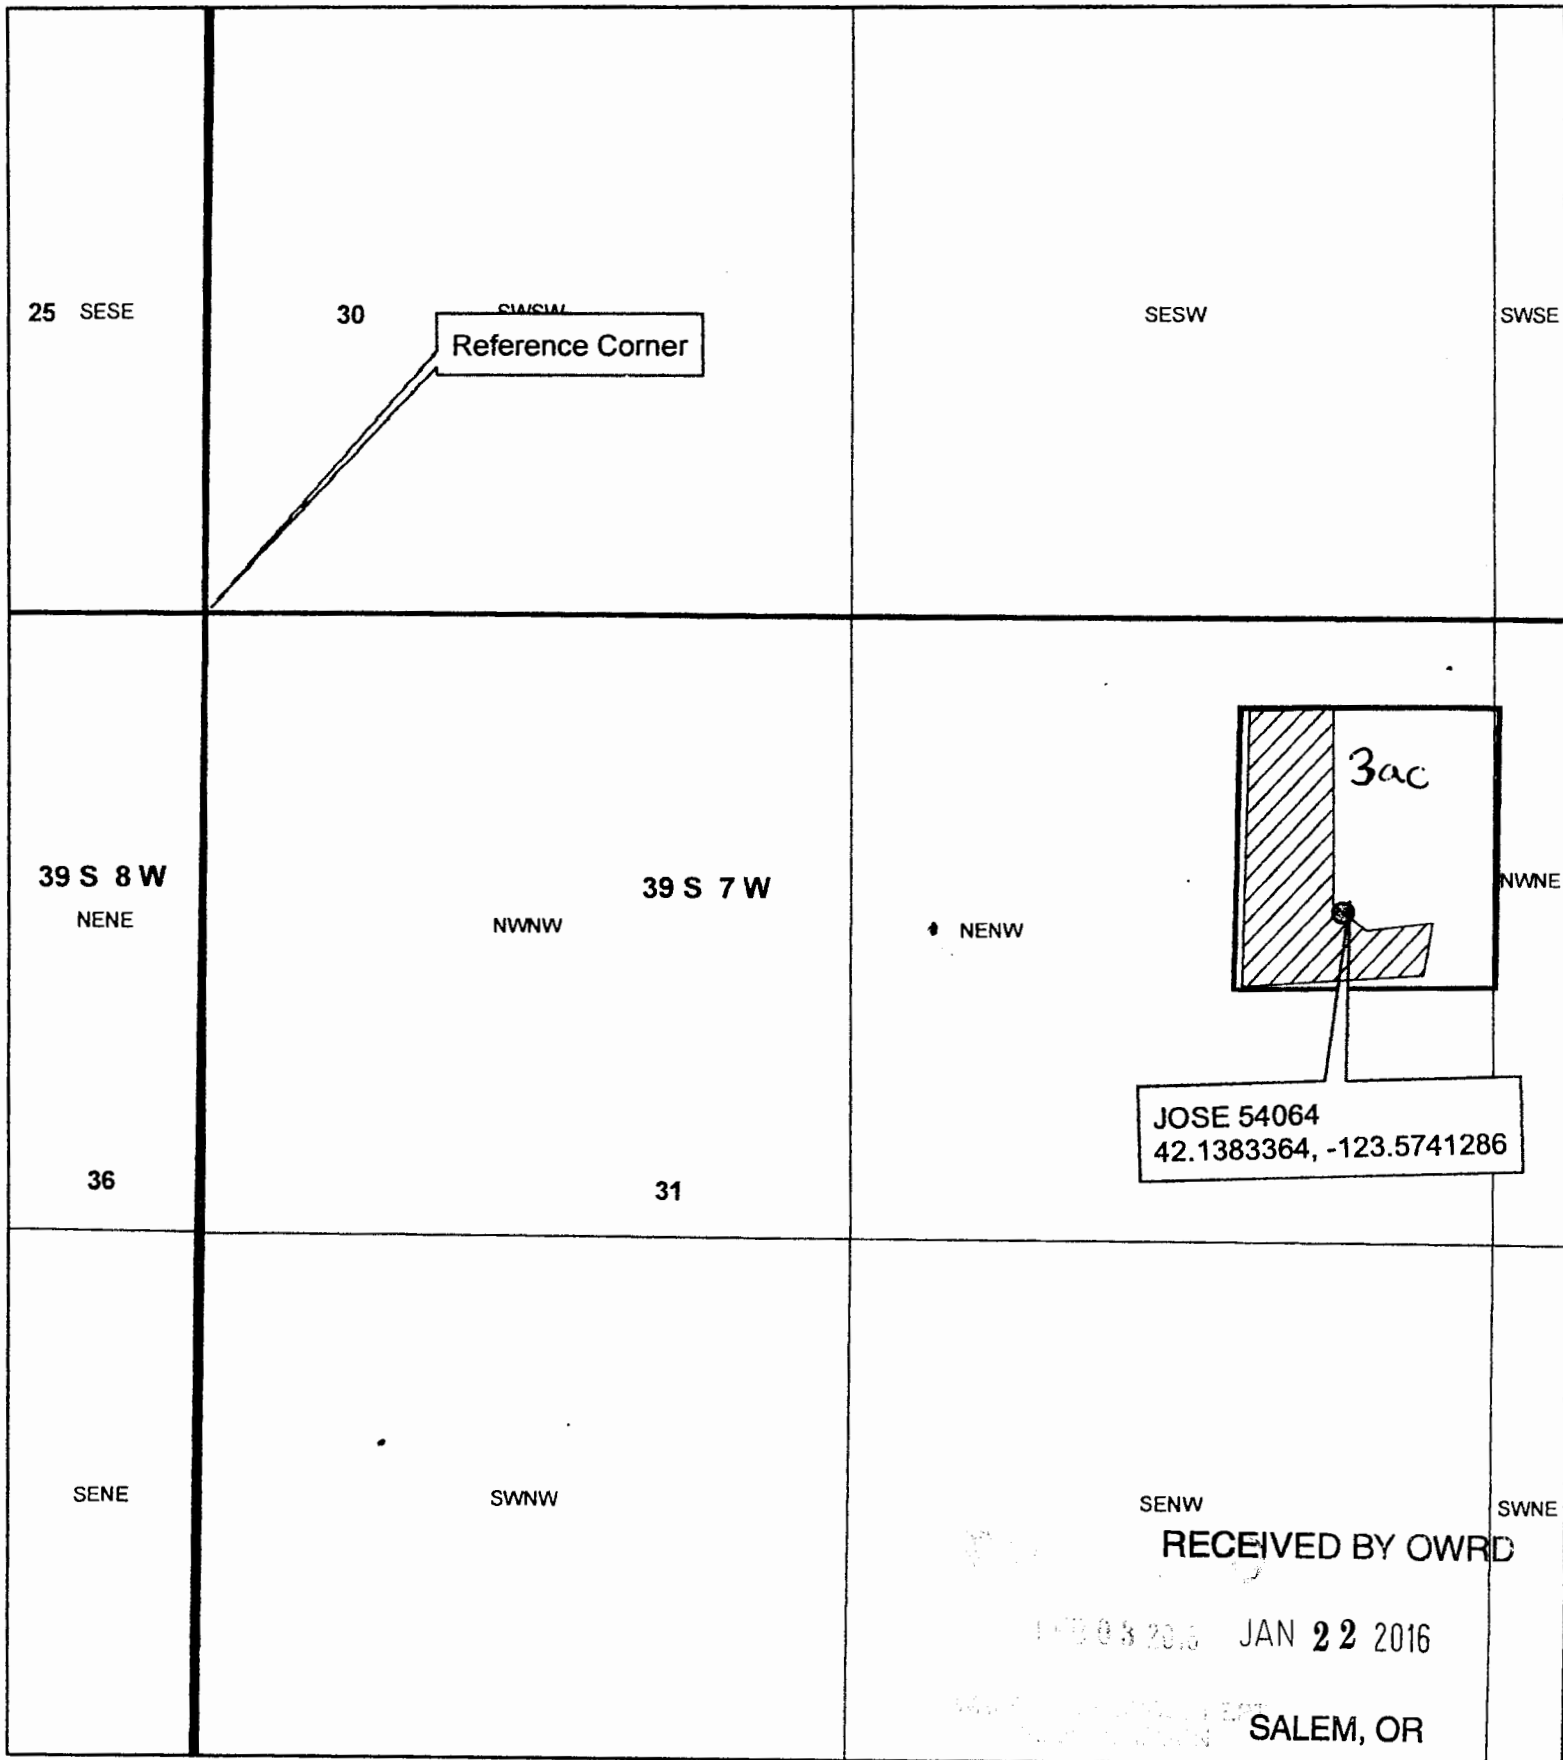


TS 39-7W-31 TL 201 NENW




JOSE 54064
42.1383364, -123.5741286

RECEIVED BY OWRD
JAN 22 2016
SALEM, OR

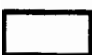Legend

-  TL 201
-  Townships
-  Sections

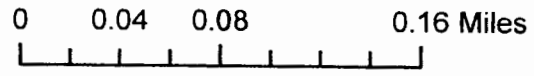

6-15-25 1" = 400'

Well (JOSE 54064) is
2363 ft East and
634 ft South of NW Corner
of Section 31

