


T 5 S., R 3 E.
Section 8, TL 400

APP G-18258 Revised map

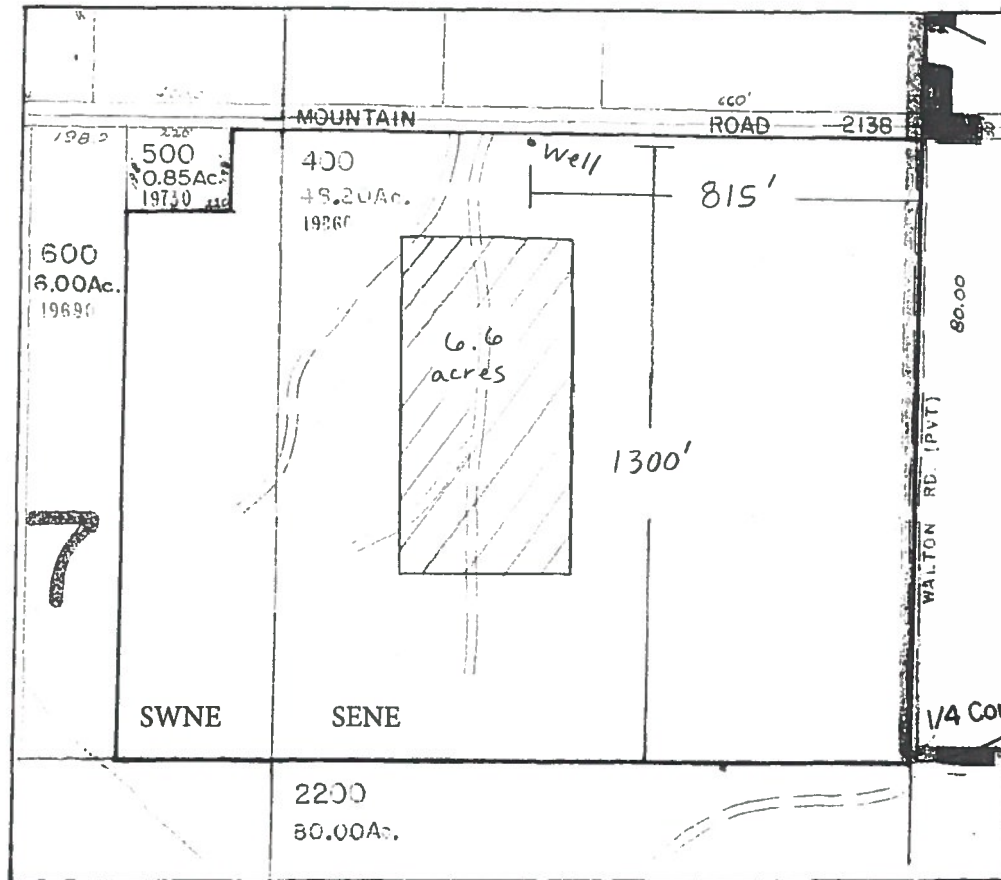

RECEIVED
JUN 28 2016
OWRD

1" = 400'

well
~~Reservoir~~ located 1300' feet North and 815 feet West from the Eastern 1/4 corner of section 8