


**T35S R7W South Half Northwest Quarter and  
North Half Southwest Quarter Section 35**

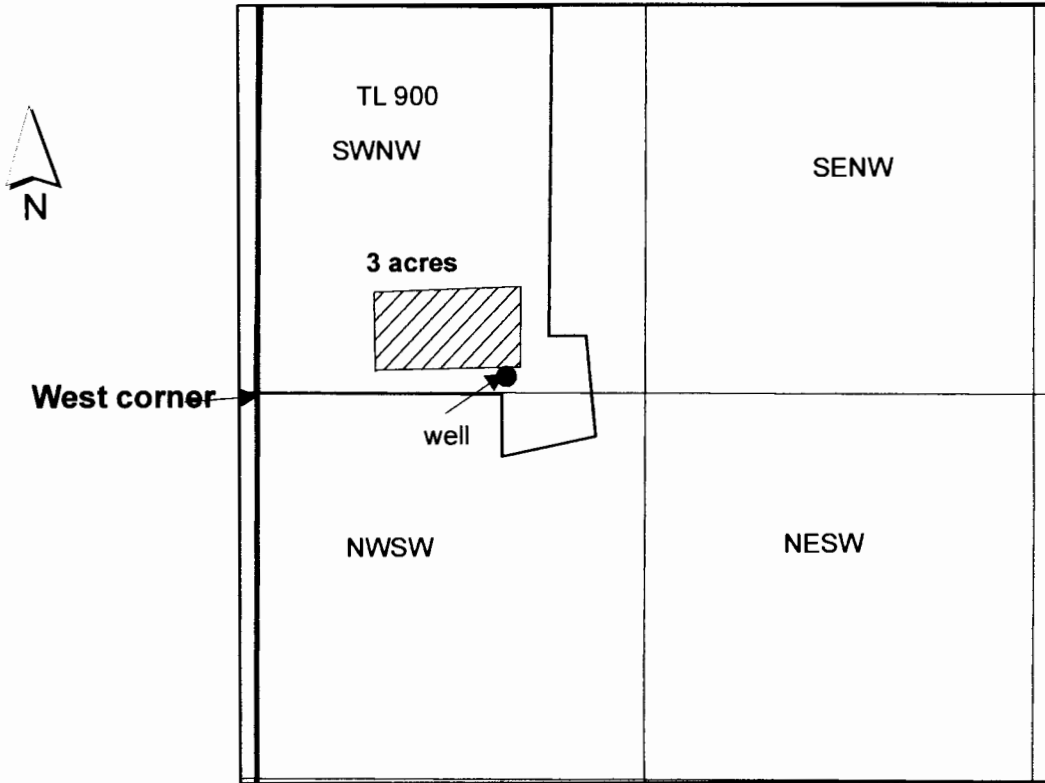

1 inch = 660 feet

**The well is located approximately 53 ft north and  
851 ft east from the west corner of Section 35.**

RECEIVED BY OWRD

JAN 25 2010

SALEM, OH

G-18259