


T38S R5W Southwest Quarter Section 32

West corner

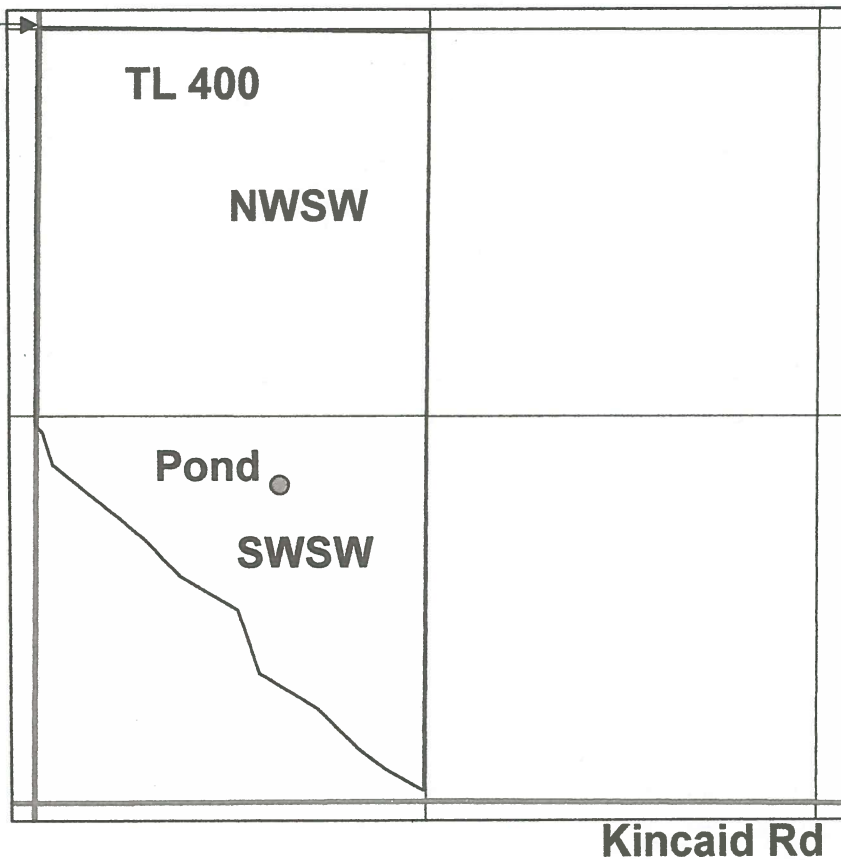

1 inch = 660 feet

Pond is 828 ft east and 1553 south of west corner.

RECEIVED BY OWRD

FEB 05 2016

SALEM, OR

R-00178