


SECTION PLAT

Section 25, 26, 35, 36 Township T 27 S Range R 34 E
 County of Harney State of Oregon

NORTH

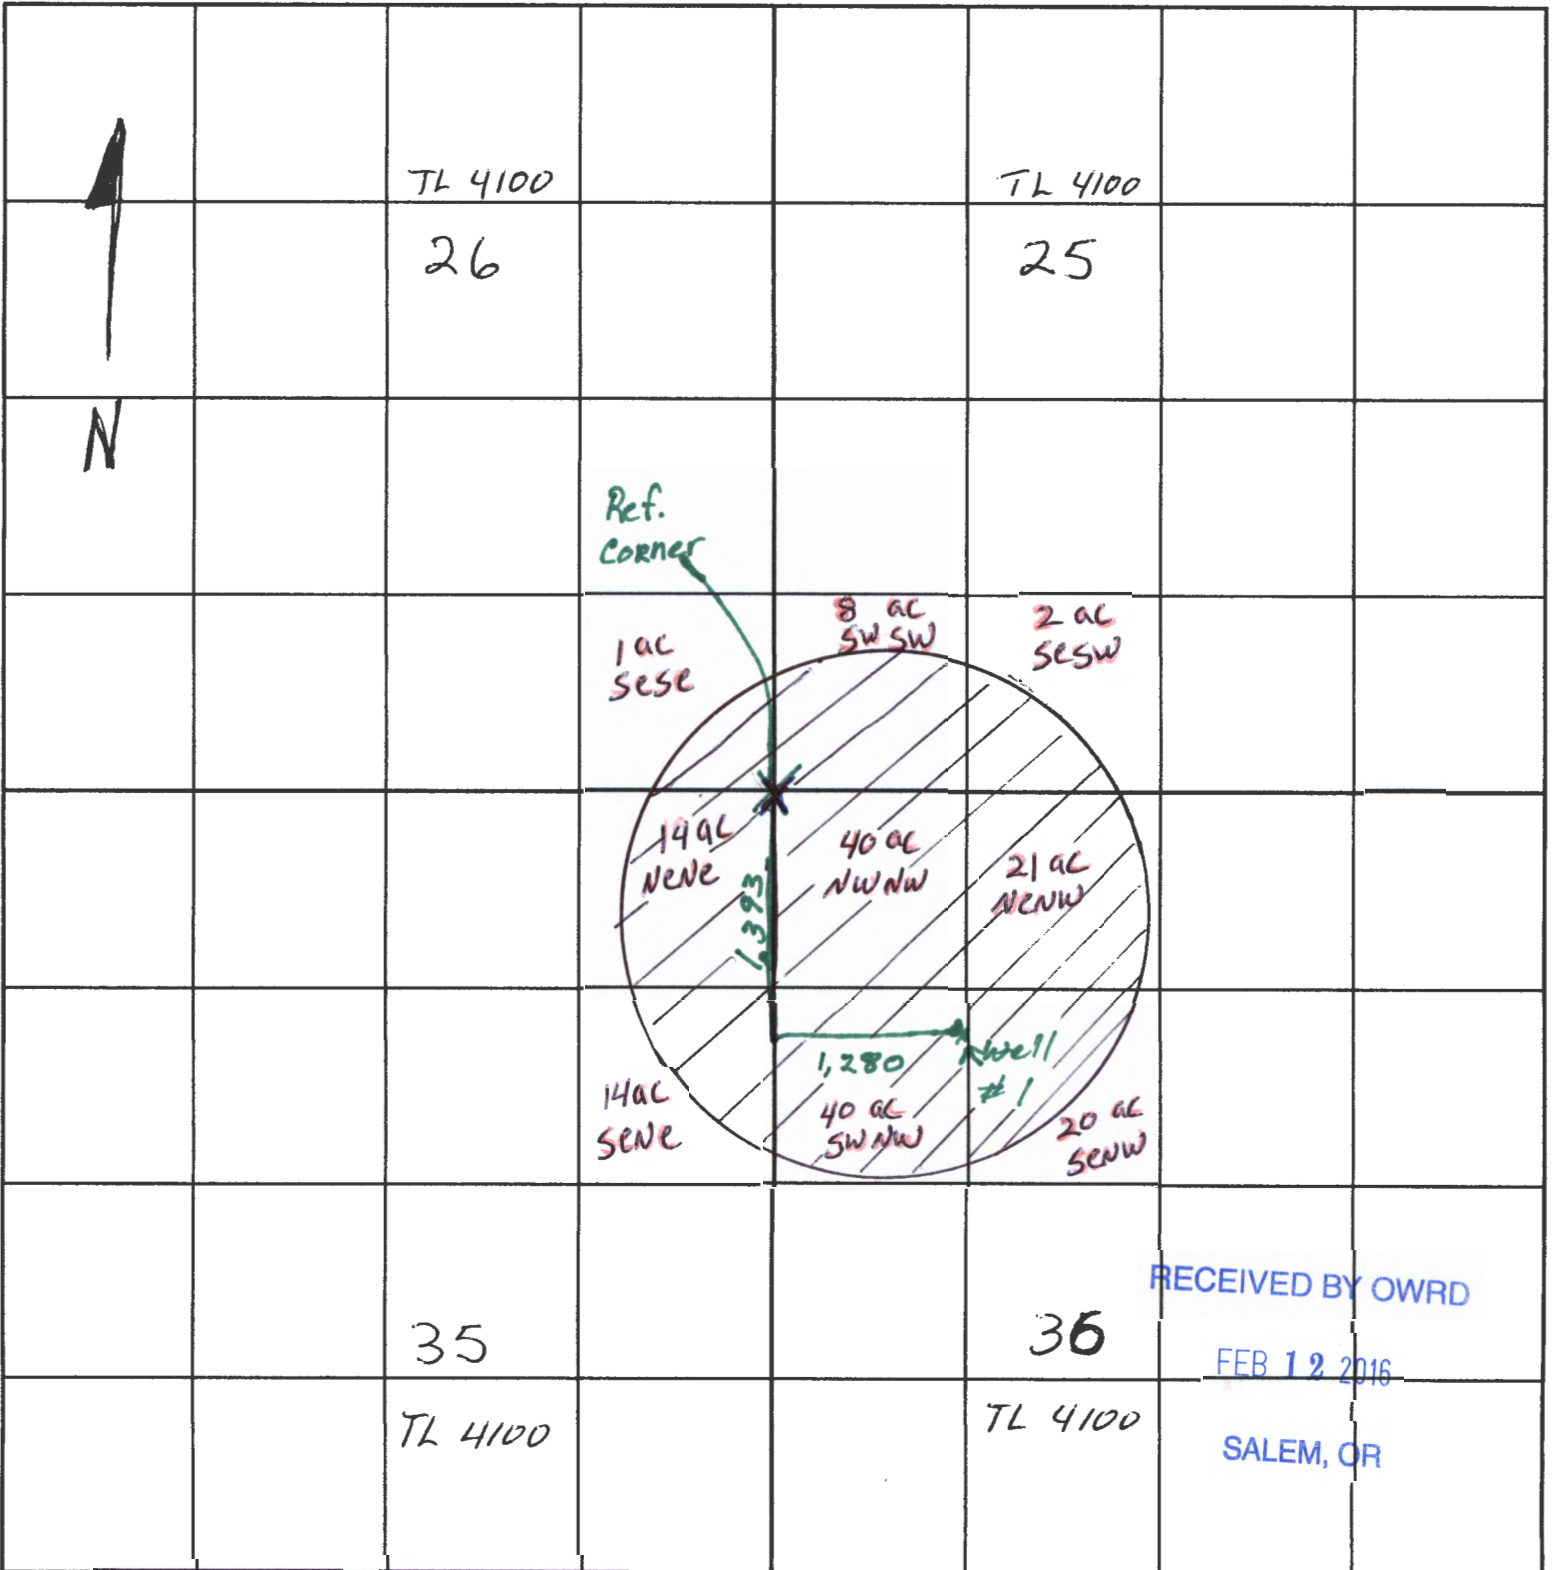

RECEIVED BY OWRD

FEB 12 2016

SALEM, OR

G-18193

4"=1 mile