


T 16 S, R 5 W, Sec 17

- From NW Cor Sec 17
- 1) 1100'S 1620'E
 - 2) 1100'S 1620'E
 - 3) 1300'S 1320'E
 - 4) 200'S 1330'E
 - 5) 270'S 1525'E
 - 6) 275 S 1700'E

1" = 500'

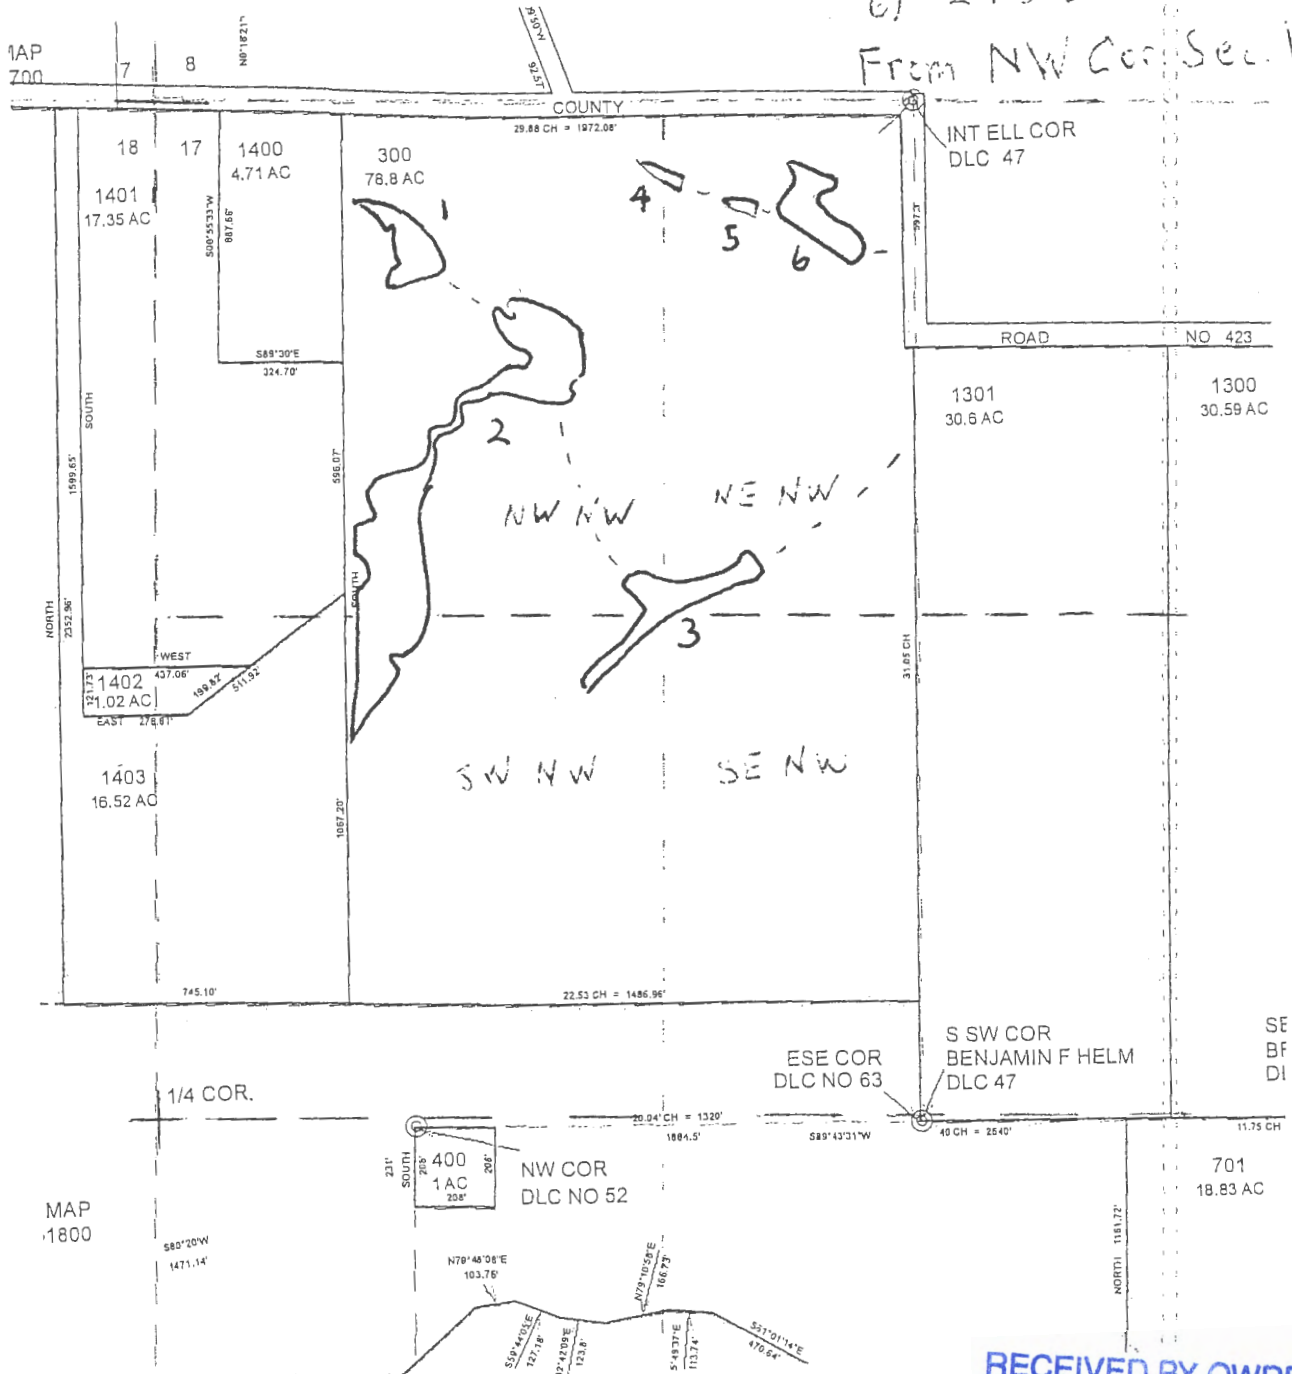

RECEIVED BY OWRD

FEB 22 2016

SALEM, OR

map for Jack Yellstedt

R-88182