


T37S R6W Northeast Section 4

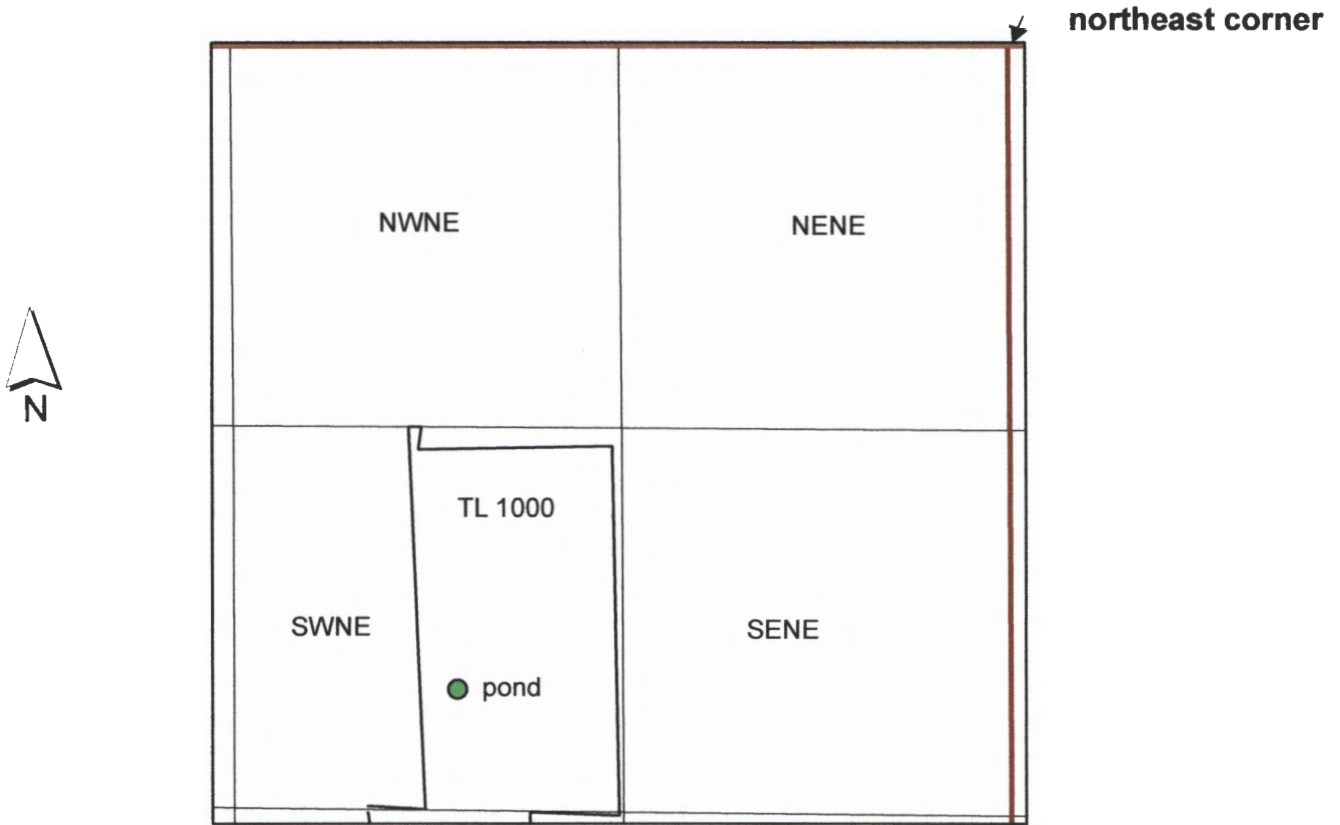

1 inch = 660 feet

The pond is located 2206 ft south and 1885 ft west of the northeast corner.

RECEIVED BY OWRD

FEB 22 2016

SALEM, OR

R-00184