


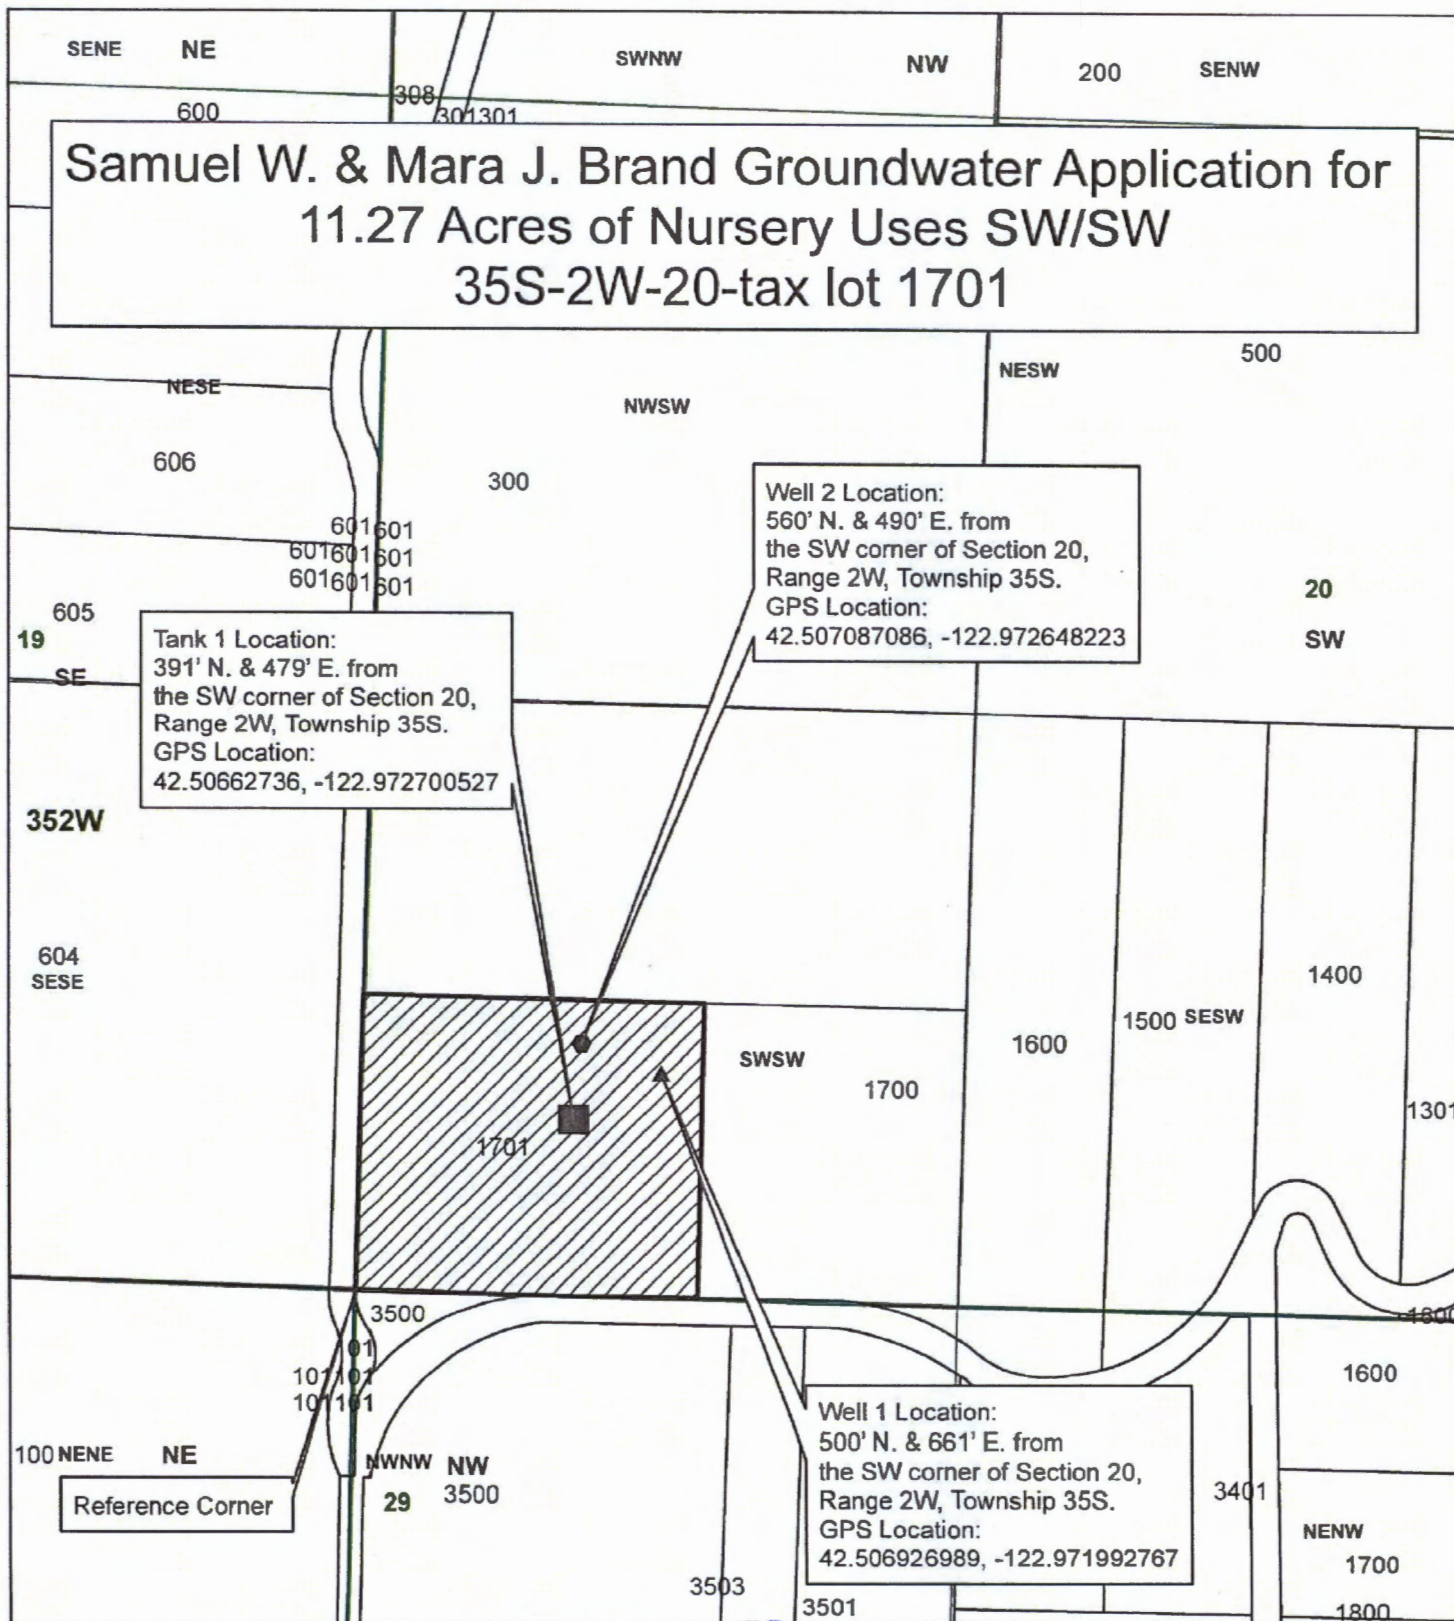

Legend


- ▲ Well 1
- Well 2
- Tank 1
- ▨ Place of Use
- Taxlot 1701
- Taxlots
- ▭ Townships
- ▭ Sections
- ▭ Quarter Sections
- ▭ Quarter Quarter Sections

RECEIVED BY OWRD

FEB 24 2016

SALEM, OR

1 inch = 400 feet

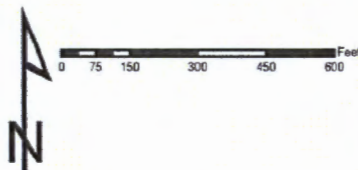

JACKSON COUNTY
WATERMASTER

Prepared by Travis Kelly

This map is based on a digital database compiled by Jackson County from a variety of sources. Jackson County cannot accept responsibility for errors, omissions, or positional accuracy. There are no warranties, expressed or implied.

Date: 02/12/2016; 35S-2W-20-tax lot 1701 Brand mxd; kelly

G-18899