


Application No. *P-80730*
 Permit No.

RECEIVED

DEC 15 1935

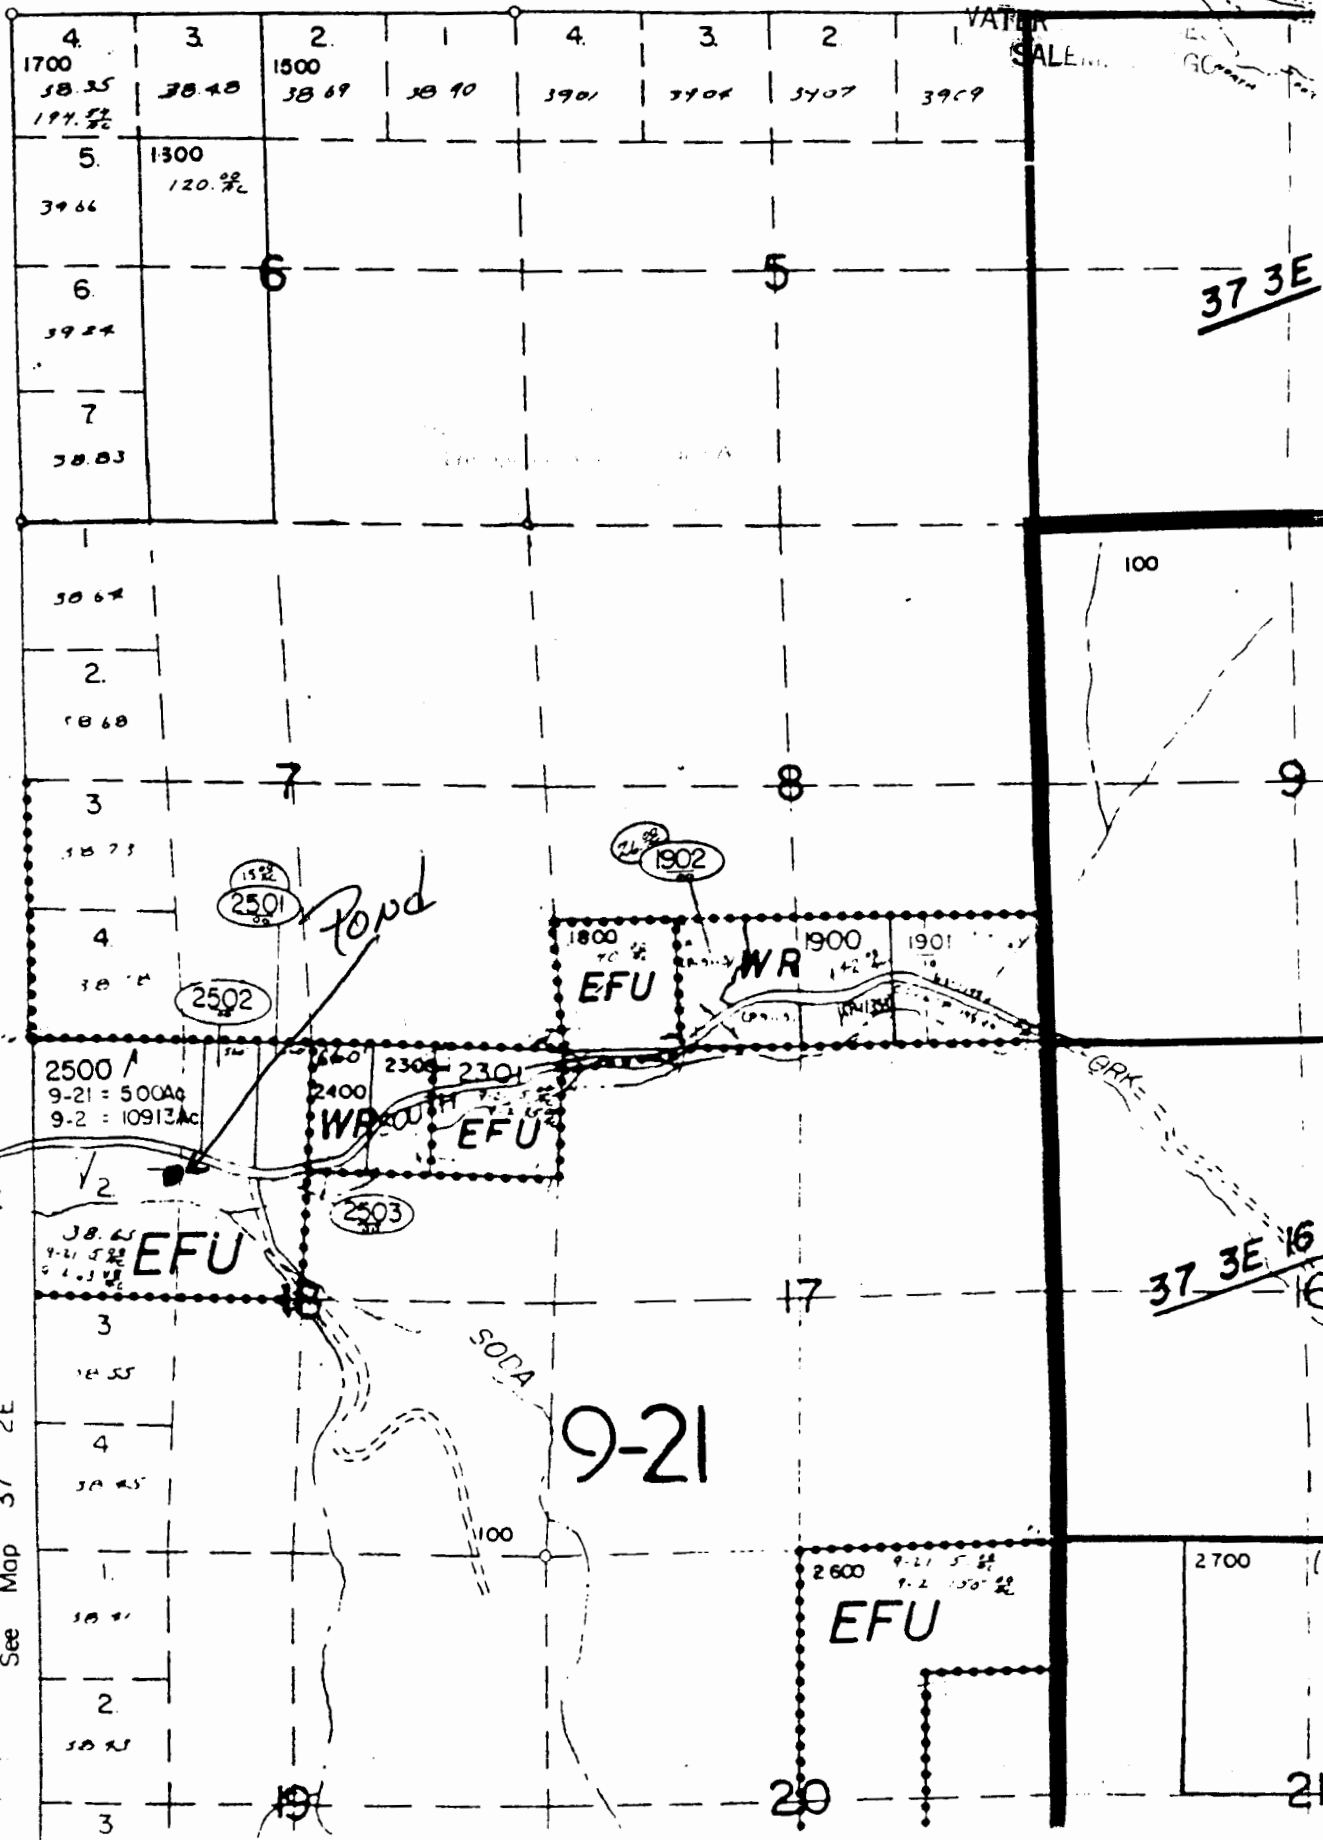

37-3E-18

See Map 37 2E

9-21

37 3E 16