


Spencer Mullen Groundwater Application for 2.5 Acres of Nursery Uses in SW/SW 35S-2W-21-tax lot 1100 9.99 Acres of nursery Uses in SE/SE 35S-2W-22-tax lot 1100

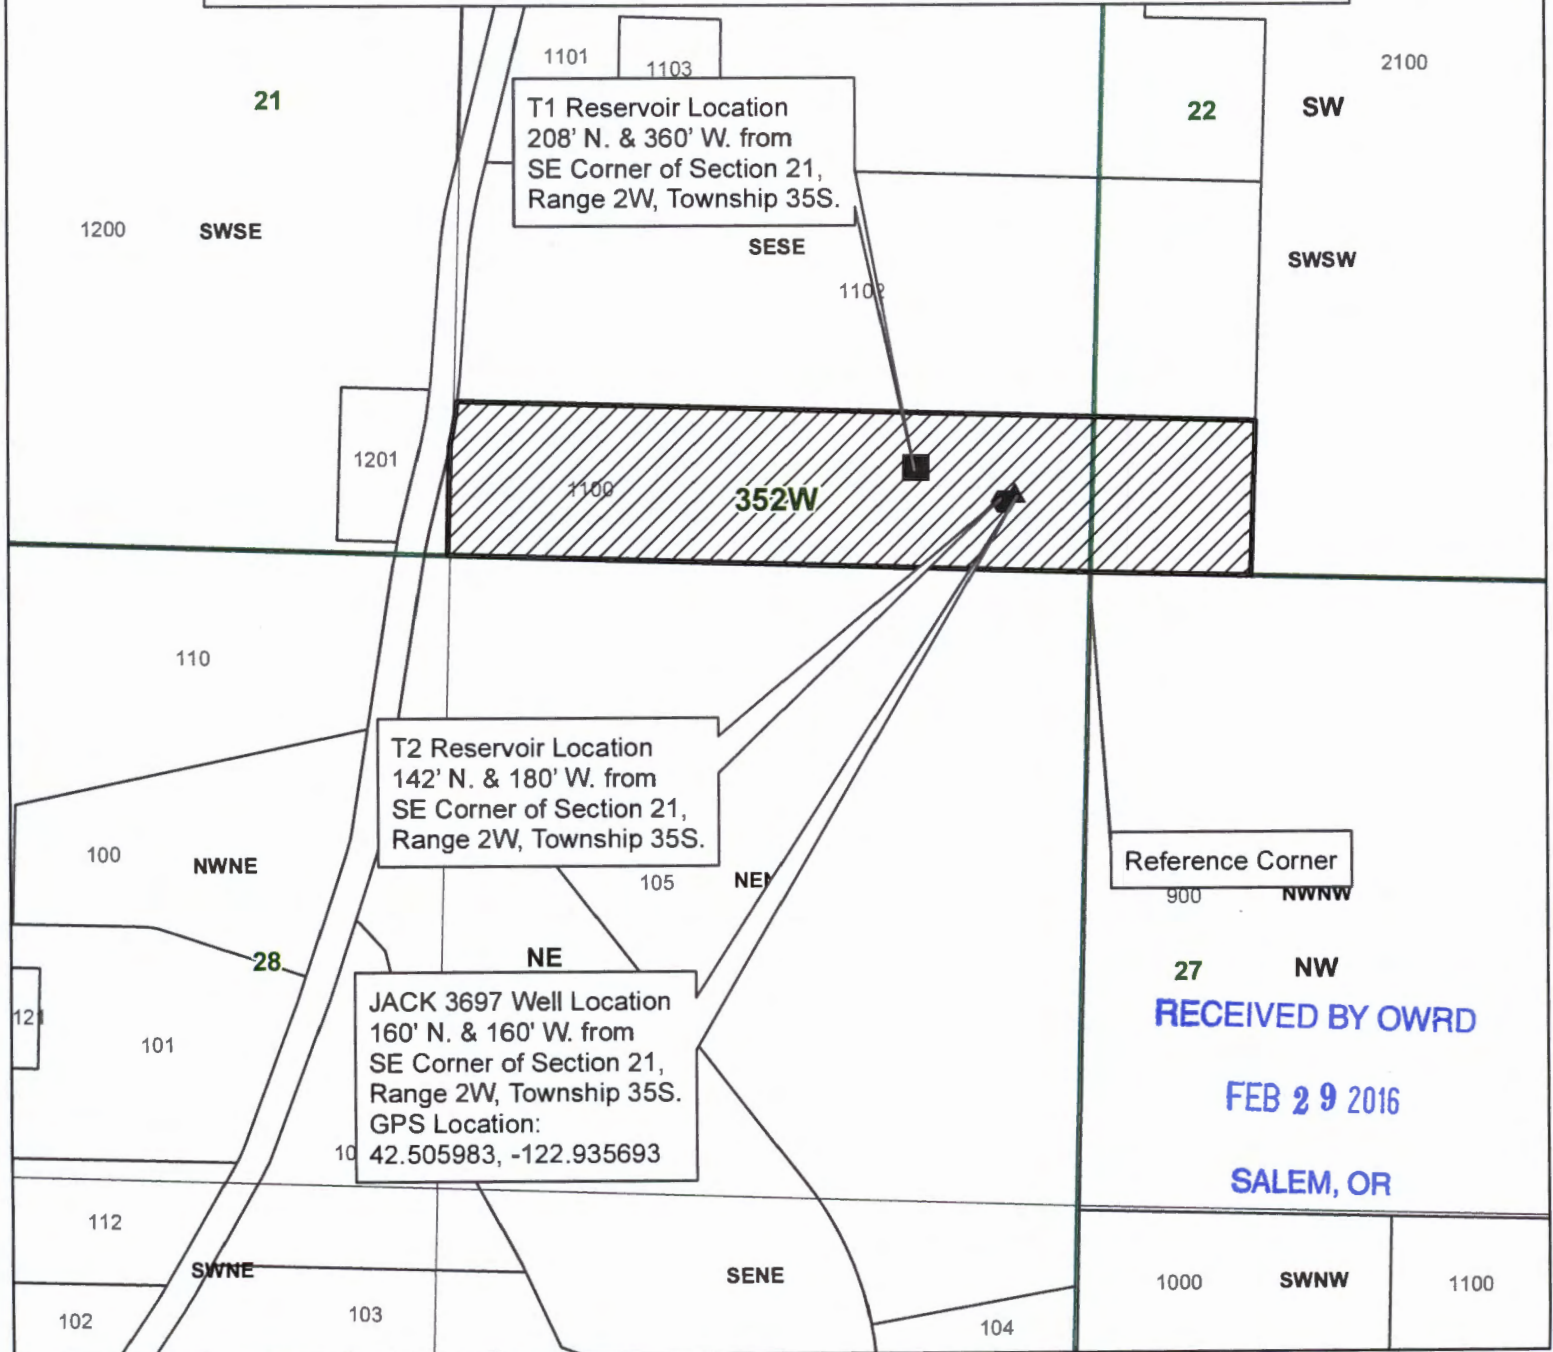

Reference Corner
900 NWNW

27 NW
RECEIVED BY OWRD


FEB 29 2016

SALEM, OR

Legend

- ▲ Well Location
- T1 Storage Location
- T2 Storage Location
- ▨ Place of Use
- Taxlot 11100
- Taxlots
- ▭ Townships
- ▭ Sections
- ▭ Quarter Sections
- ▭ Quarter Quarter Sections

1 inch = 400 feet

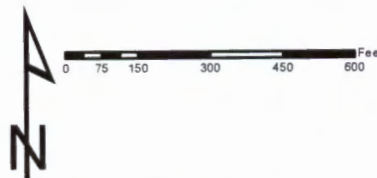

JACKSON COUNTY
WATERMASTER

Prepared by Travis Kelly

This map is based on a digital database compiled by Jackson County from a variety of sources. Jackson County cannot accept responsibility for errors, omissions, or positional accuracy. There are no warranties, expressed or implied.

Date: 01/22/2016 35-2W-21-1100 Spencer Mullen.mxd kellytr

G-18203