

# REQUEST FOR ASSIGNMENT

1. David Herman  
(Name of Applicant / Permit / Transfer Holder)

1628 NW Everett St. Portland OR 97209 (503) 819-3686  
(mailing address) (City) (State) (Zip) (Phone #)

### CHECK ONE

- ...hereby assign all my interest in and to application/permit/transfer;
- ...hereby assign all my interest in and to a portion of application/permit/transfer;  
(You must include a map showing the portion of the application/permit to be assigned.)
- ...hereby assign a portion of my interest in and to the entire application/permit/transfer;

Application # \_\_\_\_\_, Permit # \_\_\_\_\_, Transfer # T-8900 & T-8902

-OR-  
GR Statement # \_\_\_\_\_, GR Certificate of Registration # \_\_\_\_\_

as filed in the office of the Water Resources Director, to:

See attachment A. I am retaining  
(Name of New Owner)

Murray Gray, LLC and Ski Pond Ranch, LLC  
(mailing address) (City) (State) (Zip) (Phone #)

**NOTE:** If there are other owners of the property described in this Application, Permit, Transfer or Certificate of Ground Water Registration, you must provide a list of all other owners' names and mailing addresses and attach it to this form.

I hereby certify that I have notified all other owners of the property described in this Application, Permit or Certificate of Registration of this request for assignment.

Witness my hand this 2nd day of April, 2007.

Applicant/Permit holder [Signature]

Applicant/Permit holder \_\_\_\_\_

O.K. ASSIGN PARTIAL TO MULTIPLE OWNERS. [Signature] 4/18/07

### DO NOT WRITE IN THIS BOX

This certifies assignment and record change at Oregon Water Resources Department effective 8:00a.m. on date of receipt at Salem, Oregon.  
 - Fee receipt # 86972  
 - For Director by Jerry Sauter, Program Analyst in Water Rights Division  
[Signature]

The completed "Request for Assignment" form must be submitted to the Department along with the appropriate recording fees:

- \$25 for the first page, and
- \$5 for each additional page.  
(as required by ORS 538.050(1)(d))

WATER RESOURCES DEPARTMENT  
725 SUMMER STREET NE, SUITE A  
SALEM, OREGON 97301-1271

ATTACHMENT A

R & B Ranch, LLC  
Richard and Barbara Morrow  
3705 Ballyntyne Rd. S.  
Salem, OR 97302

Amestoy Ranch  
Sharon Amestoy  
2955 NE 38<sup>th</sup> Avenue  
Portland, OR 97212

Lazy Z Ranch, et all  
% Jay and Janet Poulos  
4389 Croison Ridge Way  
Salem, OR 97302

Hawks Haven Reserve, LLC  
Bruce & Marleen Rognlien  
1679 Alta Mura Rd.  
Pacific Palisades, CA 90272-2702


Willits, LLC  
William G. Willits  
16488 Wilt Road  
Sisters, OR 97759

~~LAZY Z MEADOWS~~  
~~Robinson Road Ranch, LLC~~  
~~% William G. Willits~~ PAT THOMPSON  
~~780 Duckaroo Trail, Rm 204~~ P.O. Box 267  
Sisters, OR 97759 -0267



City of Sisters  
Eileen Stein, Manager  
150 North Fir St.  
Sisters, OR 97759

Steven & Cindy Greer  
67315 Bass Ln  
Bend, OR 97701

TOWNSHIP 15 SOUTH, RANGE 10 EAST, W. M.

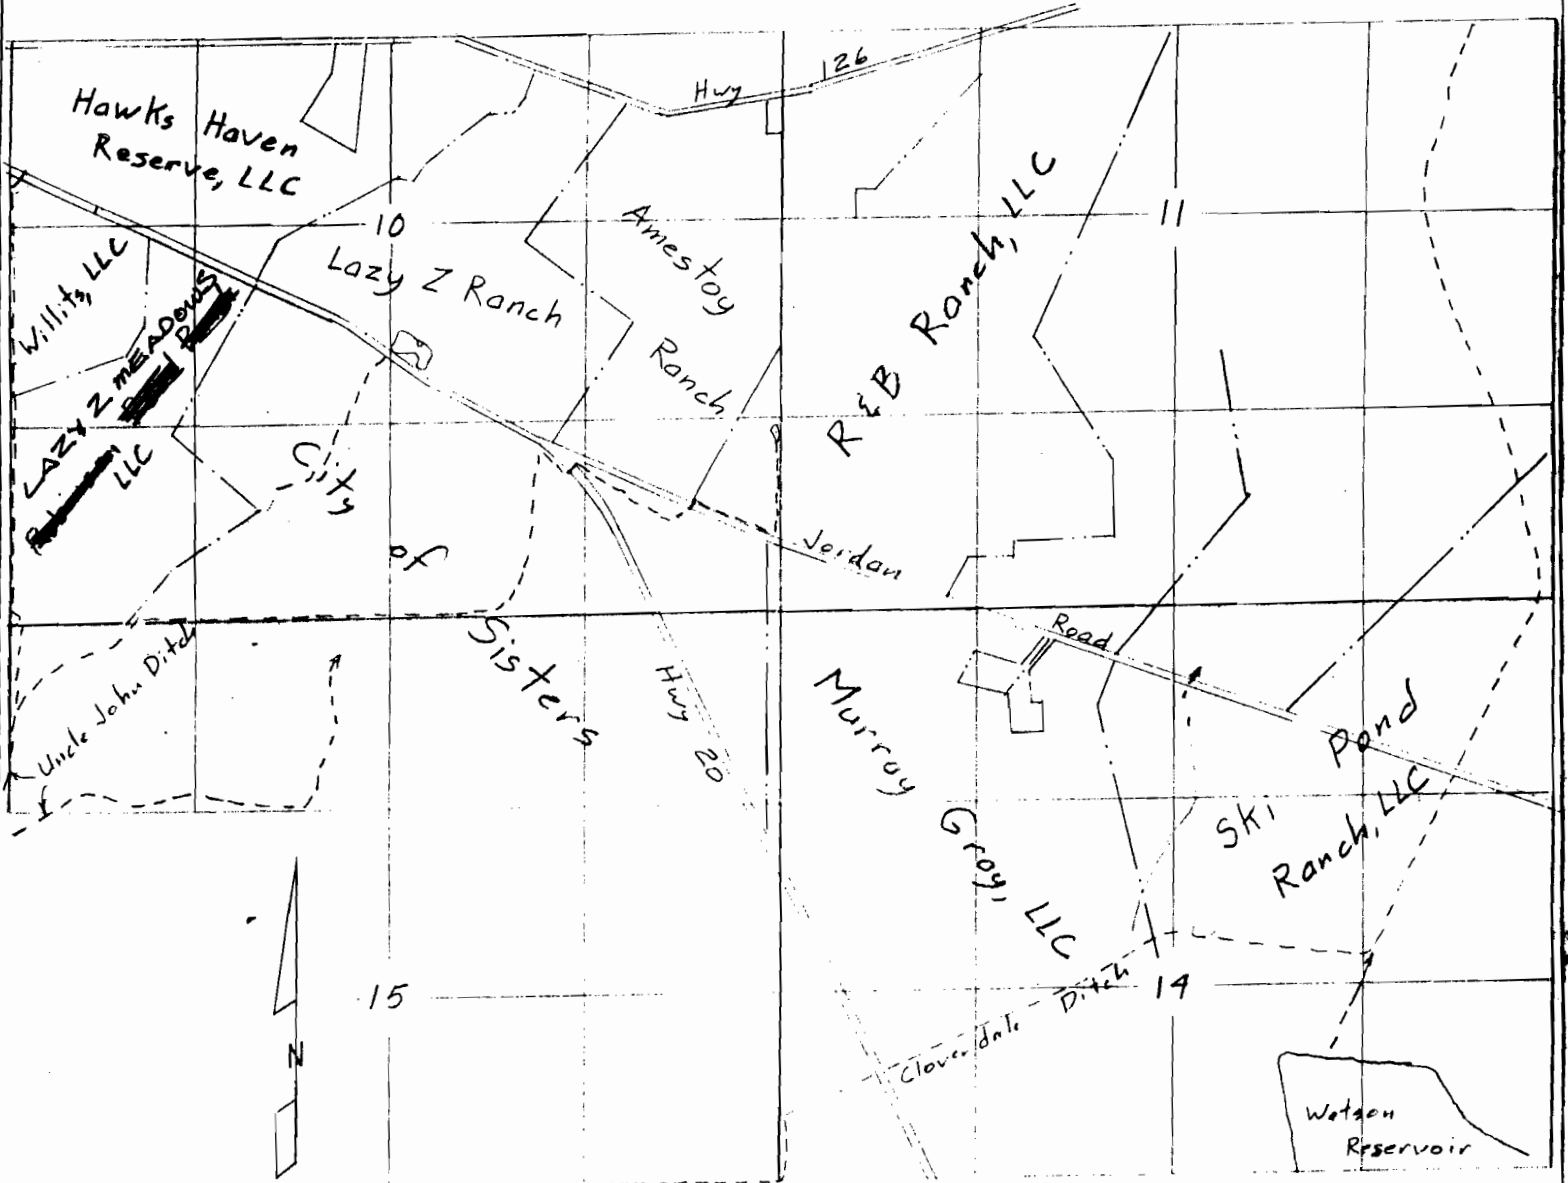

Scale 1" = 1320'

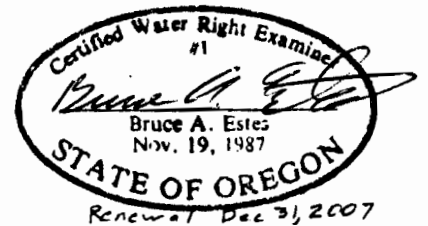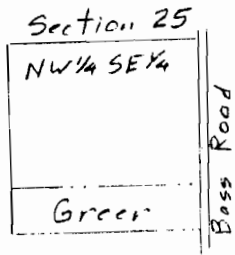

This map is for the purpose of locating a water right only and has no intent to provide legal dimensions or the location of property lines.

**ESTES SURVEYS, LLC**  
 PO Box 17519      60382 Arnold Rd  
 Salem, OR 97305-7519      Bend, OR 97702  
 (503) 585-7593      (541) 382-7391