35 1E

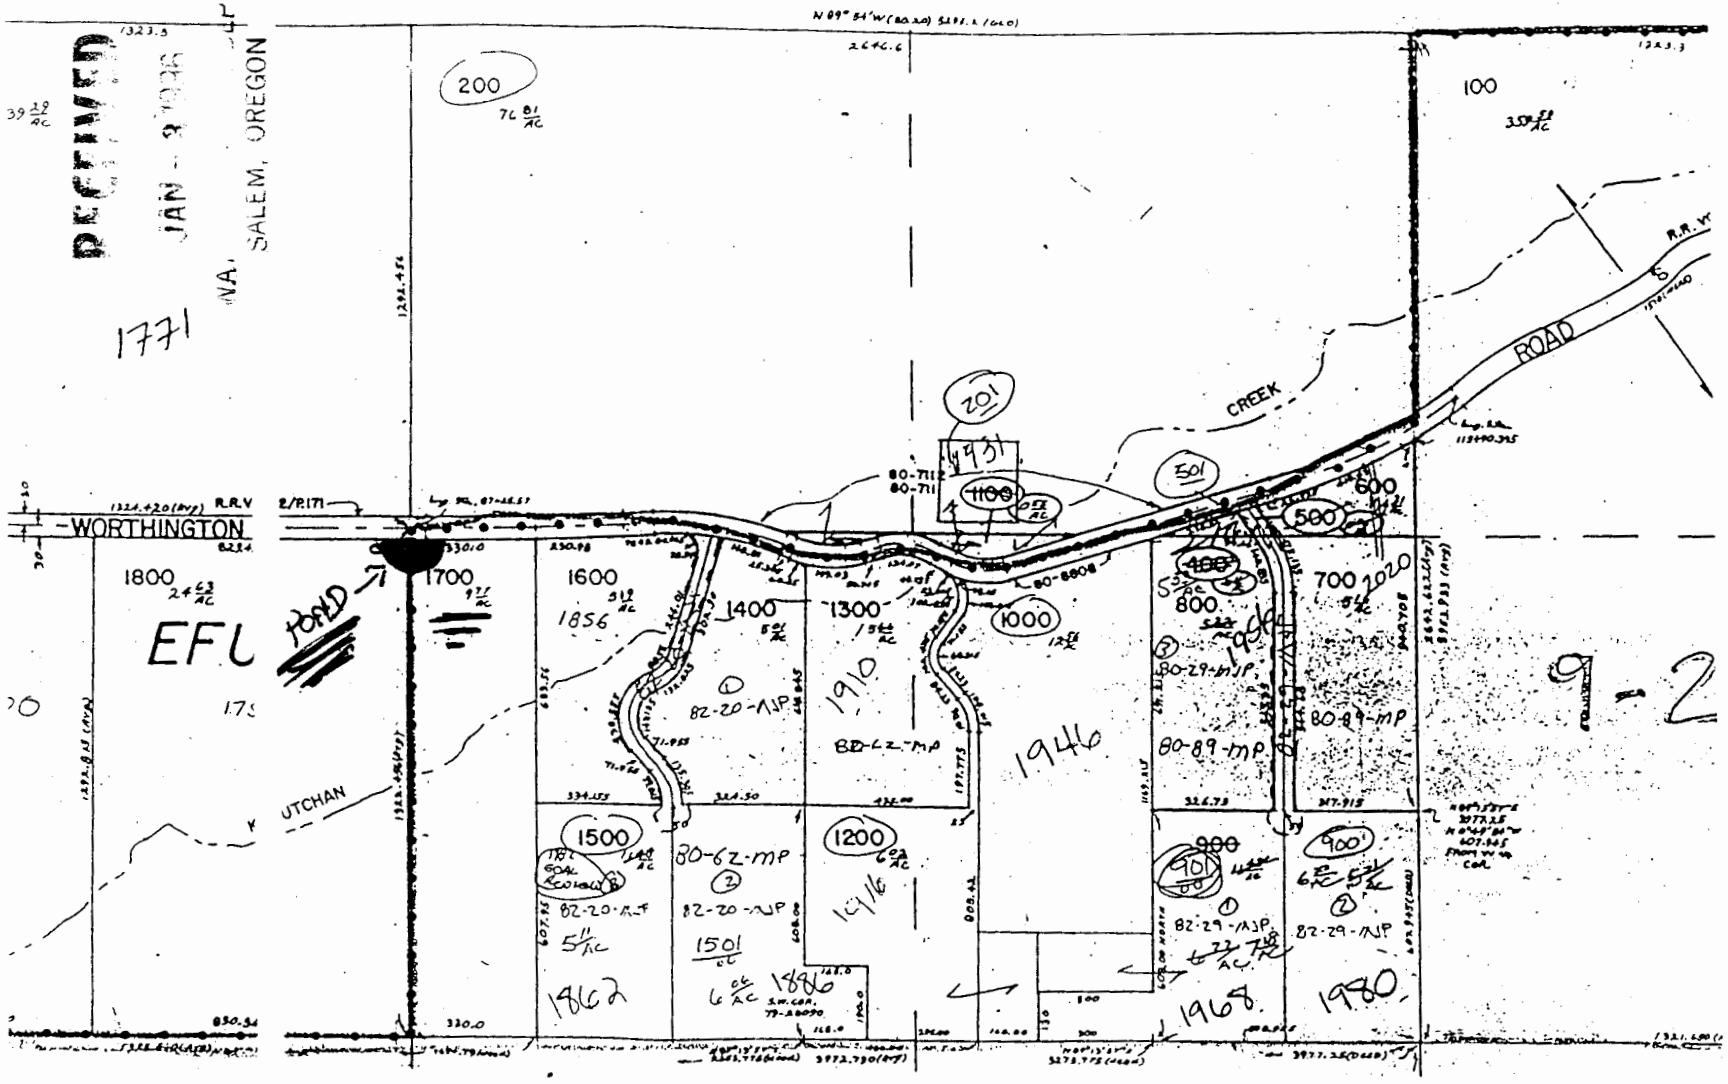
RECEIVED
JAN - 3 1986
SALEM, OREGON
WORTHINGTON
EFU
POND
UTCHAN
CREEK
ROAD
200
100
201
501
1100
1000
1800
1700
1600
1400
1300
1500
1200
900
901
800
700
600
500
400
1856
1910
1946
1916
1862
1886
1968
1980
82-20-MP
80-62-MP
82-20-MP
80-29-MP
80-89-MP
82-29-MP
80-711
80-8808
1771
9-2
Application No. 80-835
Permit No.