


8s 5w 3

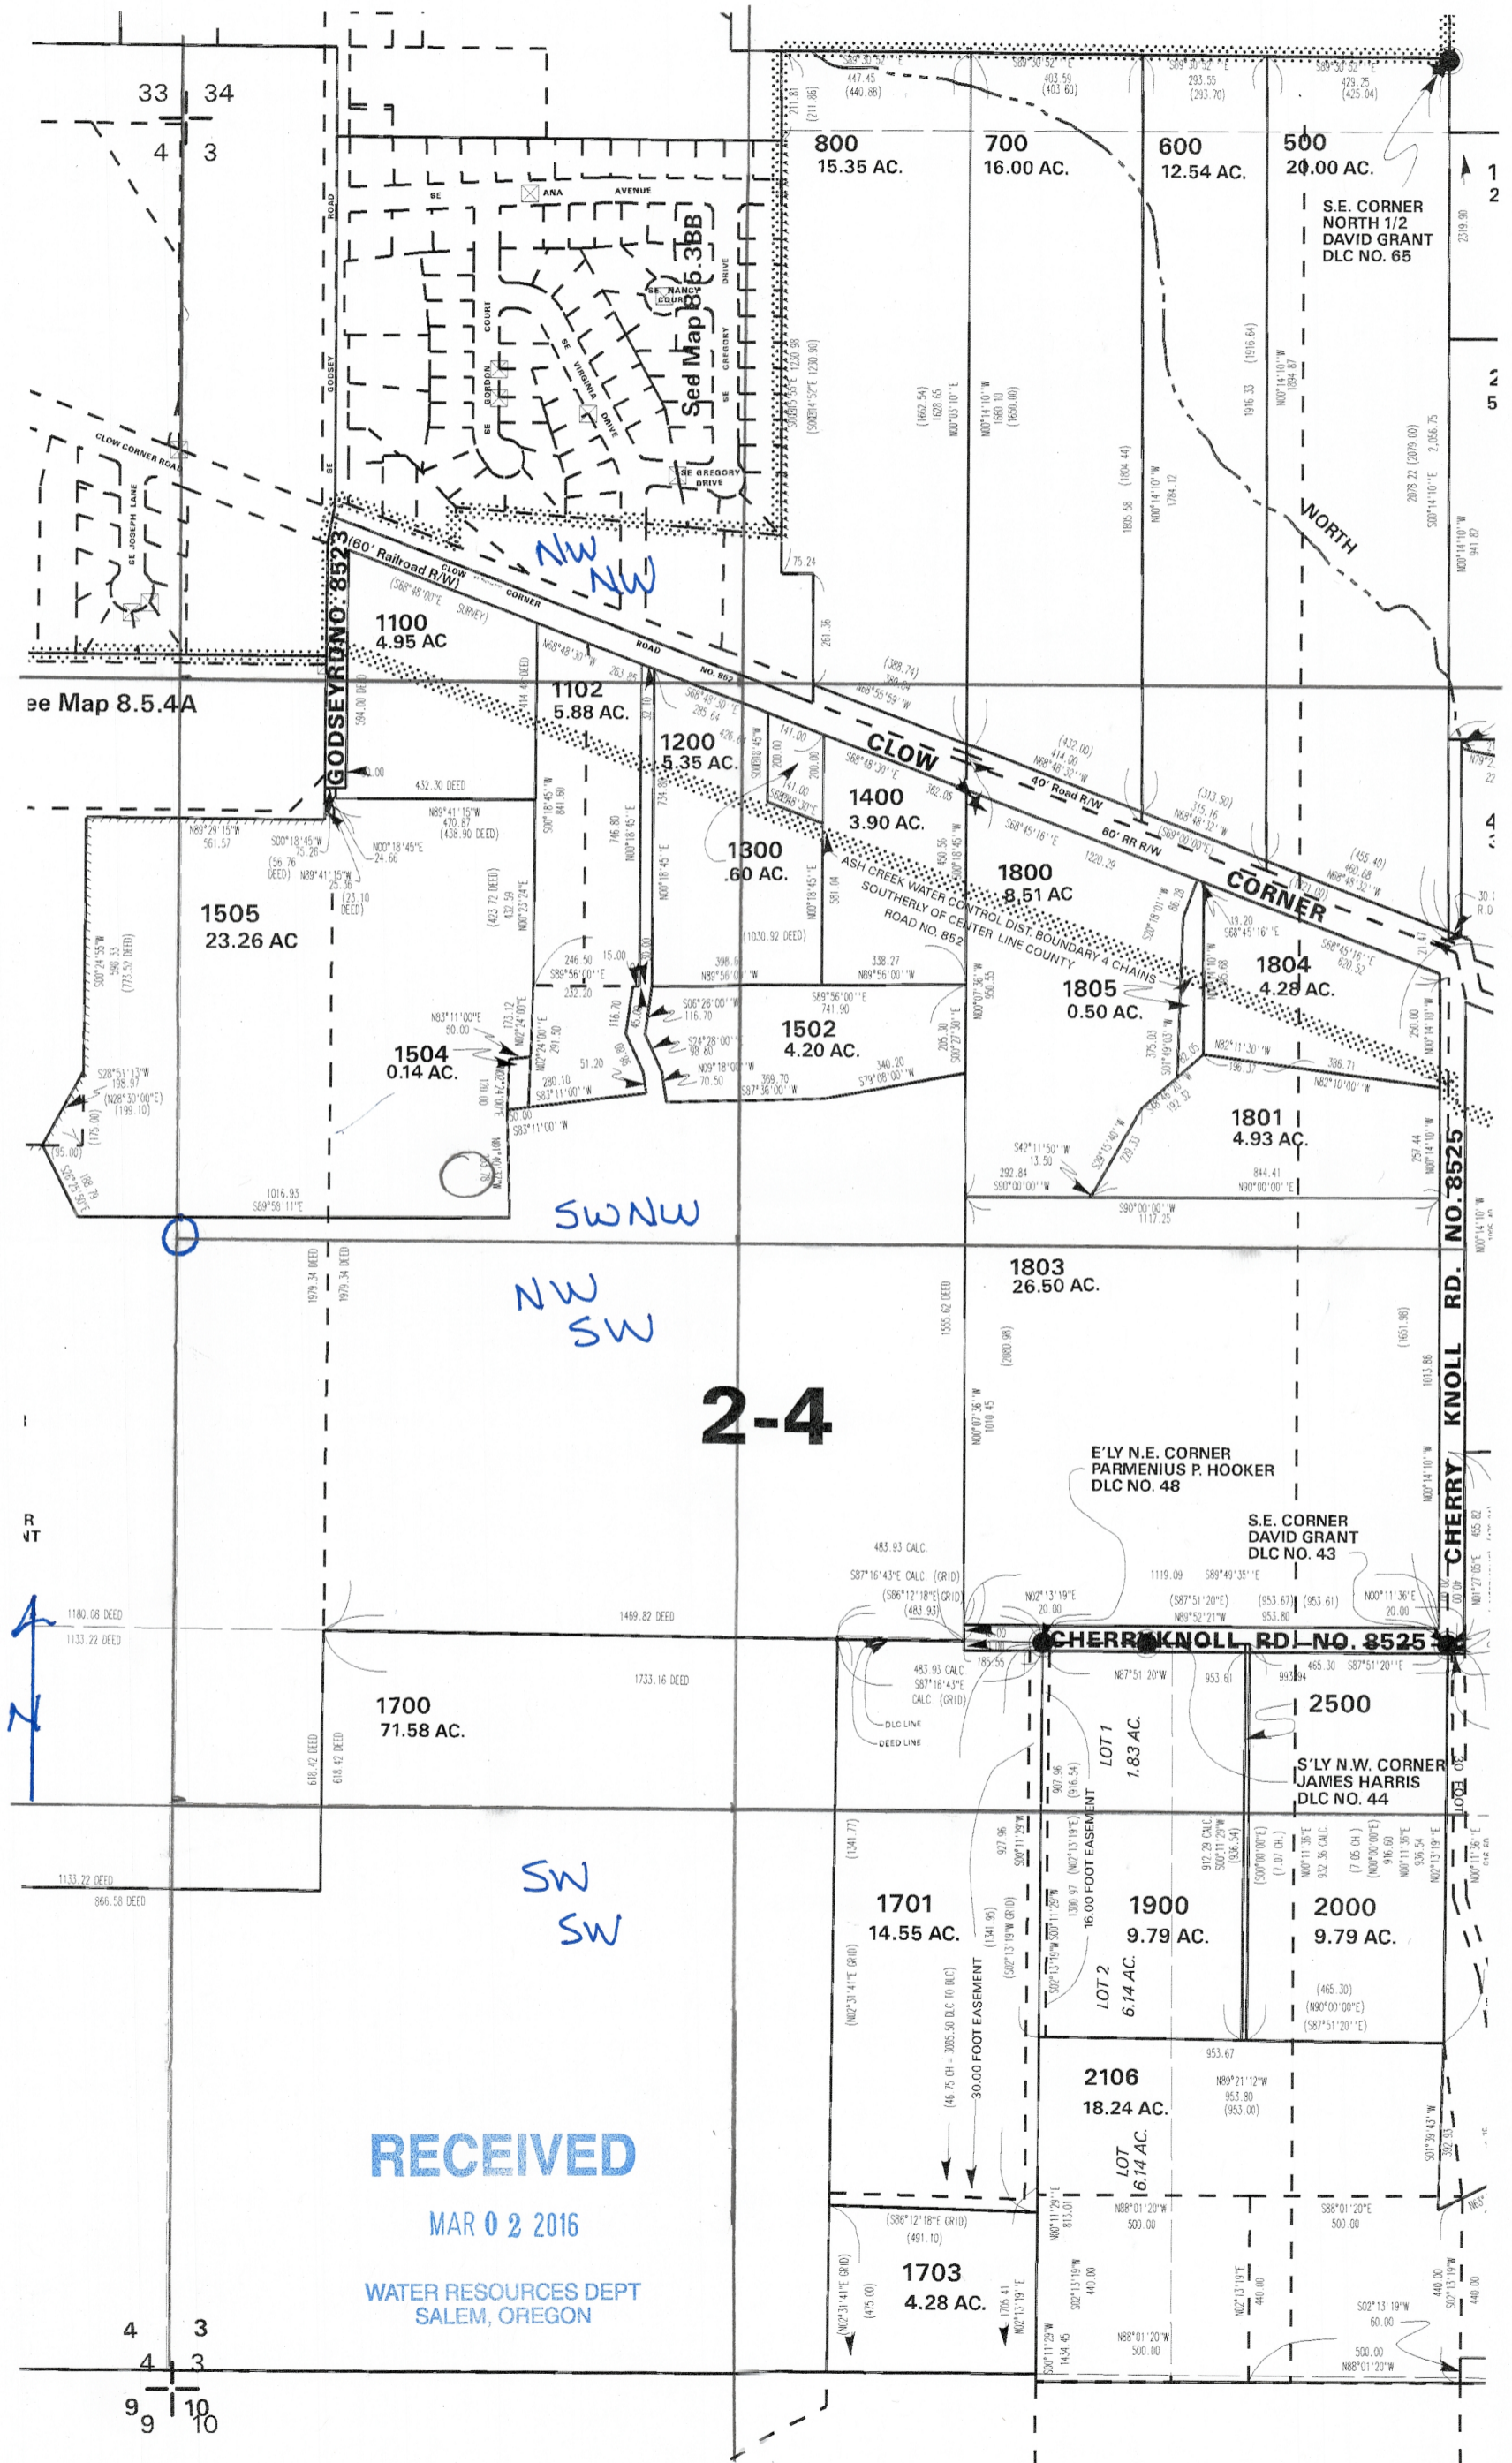

RECEIVED

MAR 02 2016

WATER RESOURCES DEPT
SALEM, OREGON

680' east 160' north of the West 1/4 corner of section 3