

LOCATION OF WELL

Well Label L113934

Latitude 43.74340000

Longitude -123.07207000

Township / Range / Section / Quarter - Quarter Section / Taxlot

21.00S 3.00W 17

SENE

1000

RECEIVED

RECEIVED BY OWRD


MAR 16 2016

MAR 16 2016

WATER RESOURCES DEPT
SALEM, OREGON

SALEM, OR

N ↑

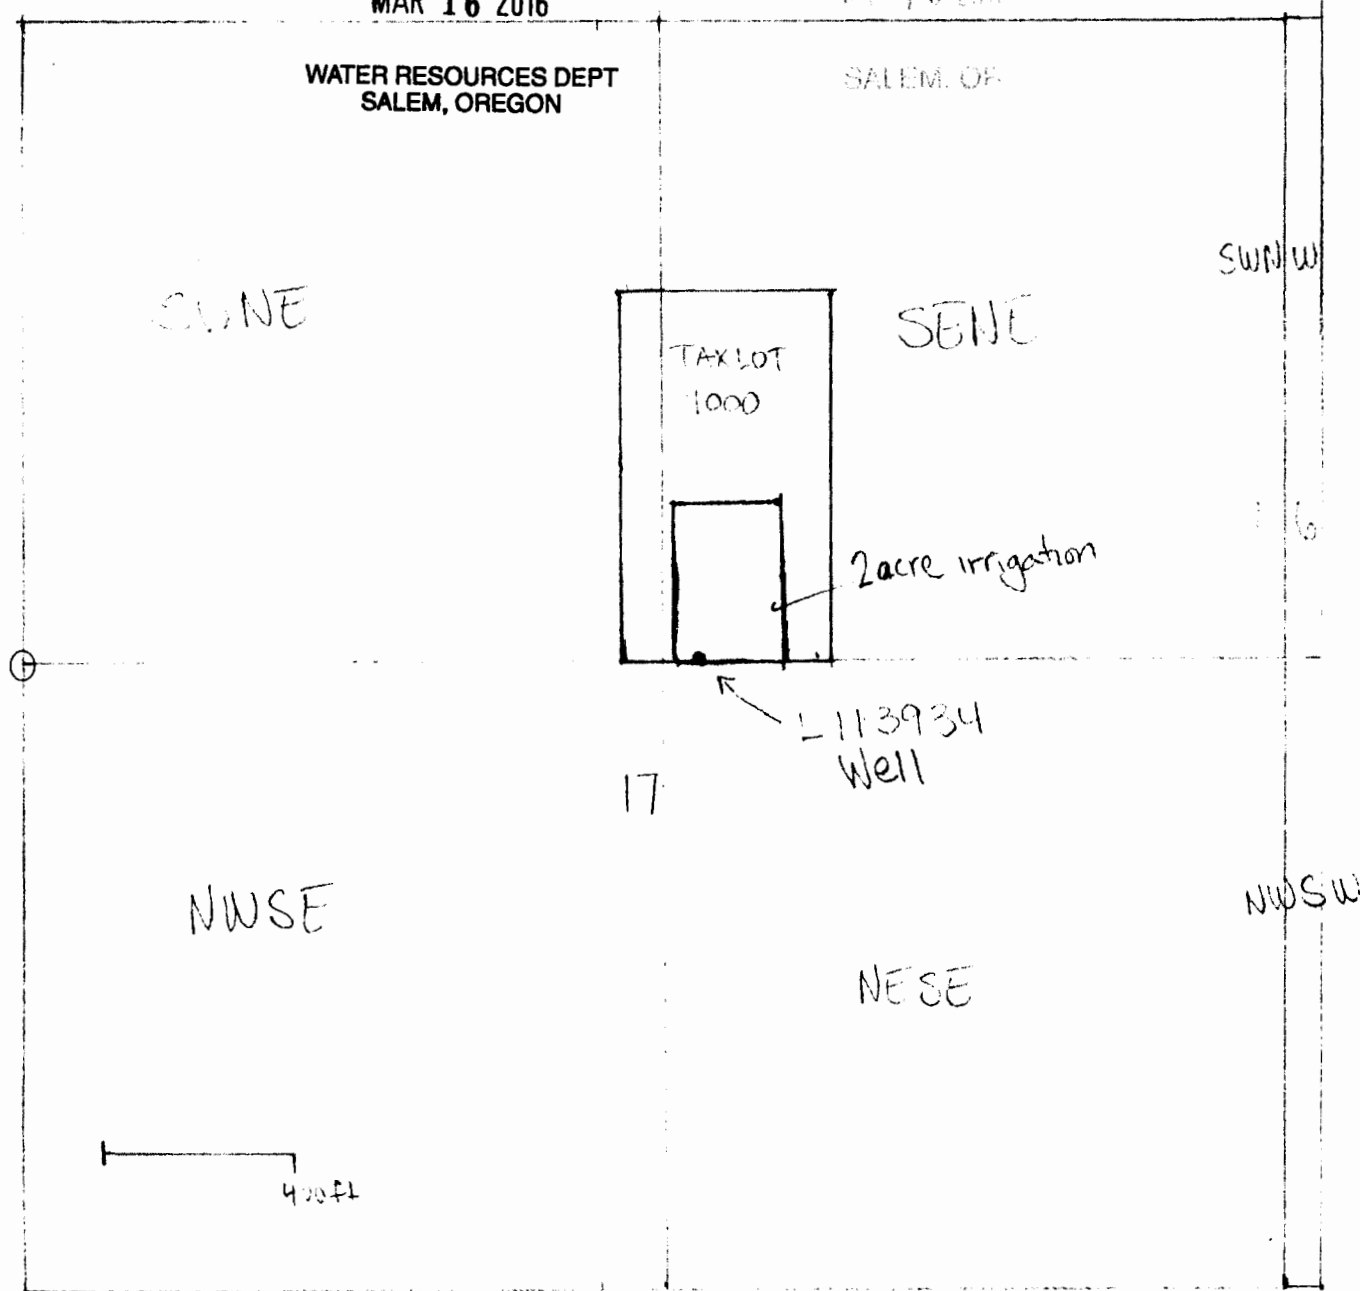

Well located approx. 1330 feet east and 10 feet north from the center of section 17

G-18214

LOCATION OF WELL

Well Label L113934

Latitude 43.74340000

Longitude -123.07207000

Township / Range / Section / Quarter - Quarter Section / Taxlot

21.00S 3.00W 17

SENE

1000

RECEIVED BY OWRD

MAR 16 2016

N ↑

SALEM, OR



TAXLOT
1000

SENE

2 acre irrigation

L113934
Well

17




400 ft

G-18214