

RECEIVED BY OWRD

MAR 14 2016

SALEM, OR




Scale: 1" = 1320'

Map to accompany Tom & Fawn Kerns Groundwater Application


⊙ Proposed Well Locations

 Primary Irrigation

 Supplemental Irrigation

T. 8S, R. 38E


T. 8S, R. 39E

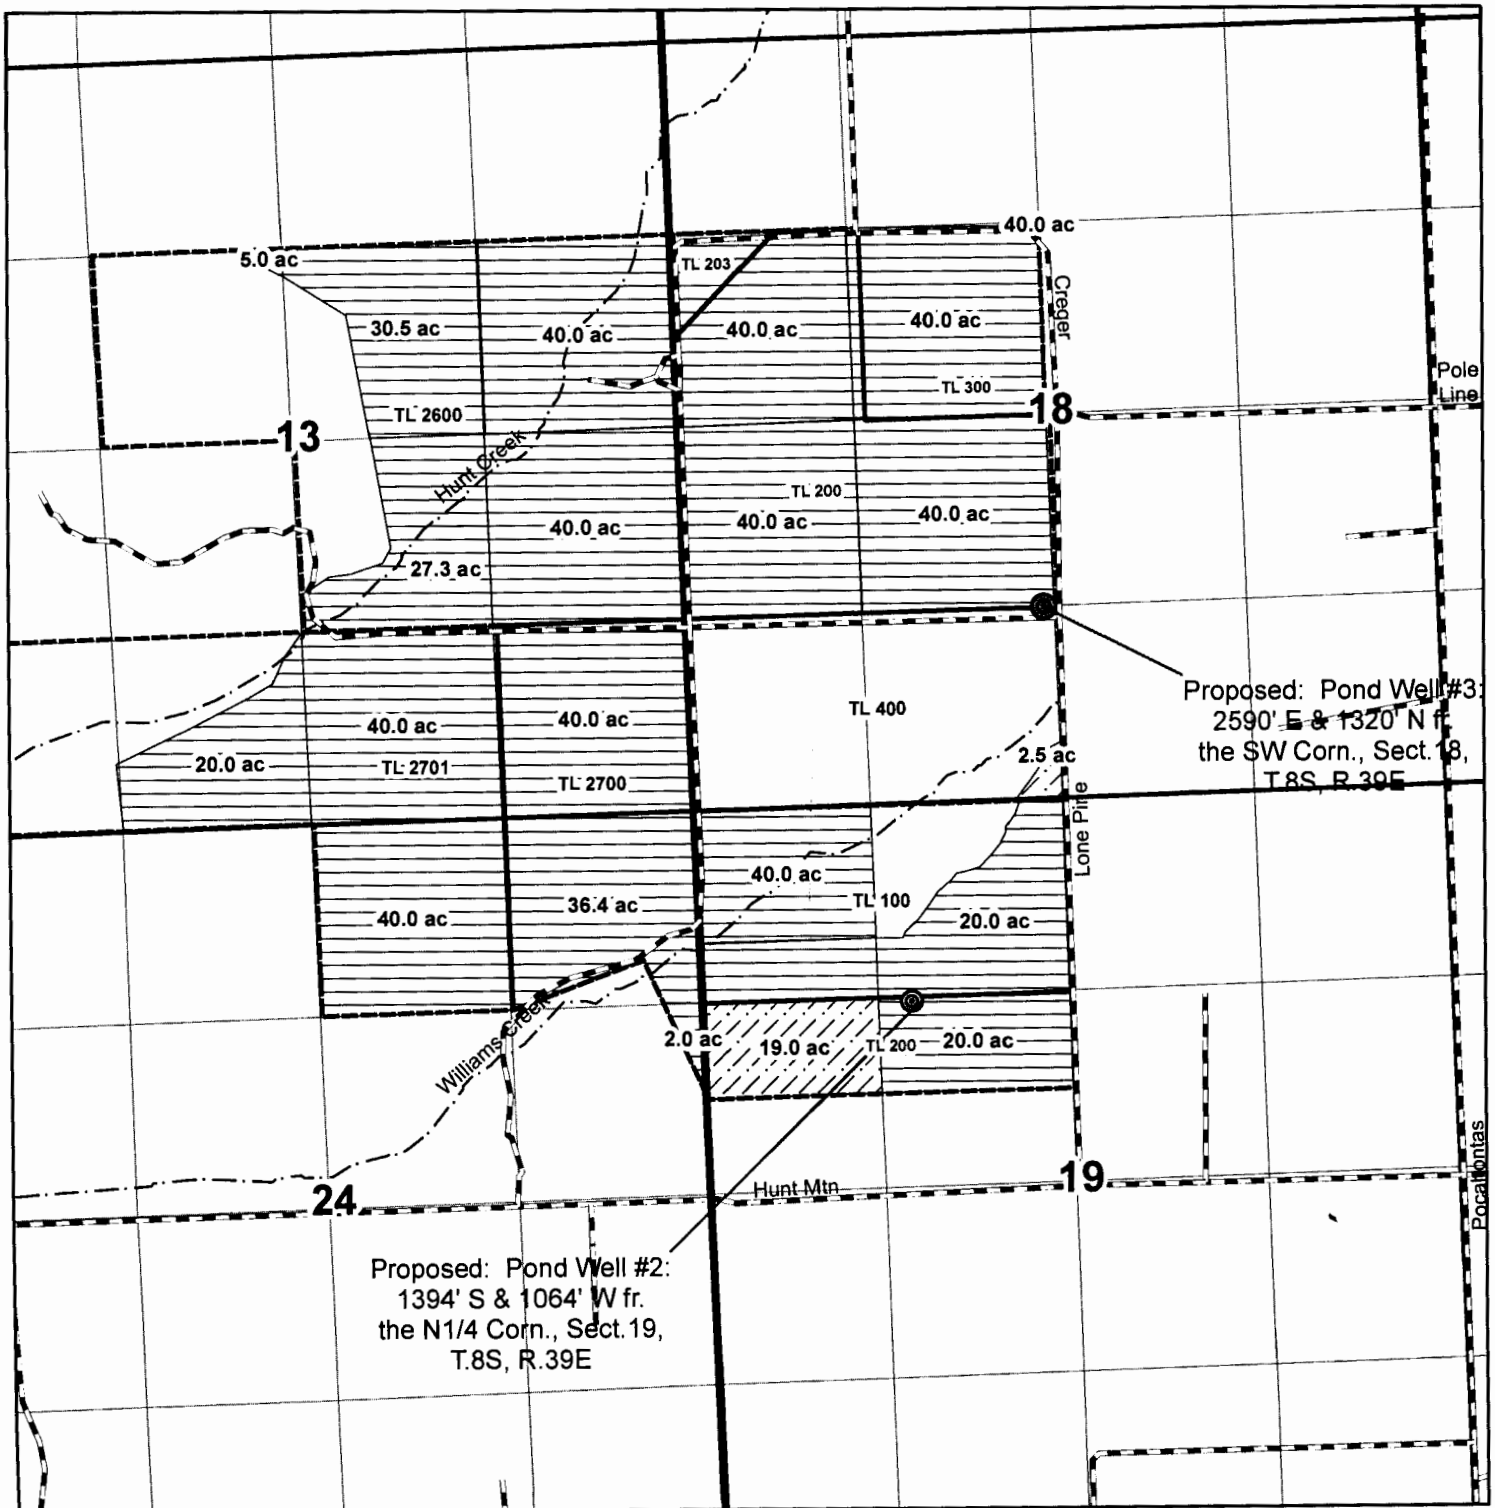

RECEIVED BY OWRD

MAR 14 2016

SALEM, OR

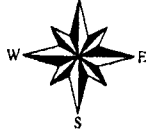


Scale: 1" = 1320'

Map to accompany Tom & Fawn Kerns Groundwater Application

● Proposed Well Locations




Primary Irrigation

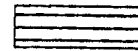

Supplemental Irrigation

T. 8S, R. 38E T. 8S, R. 39E

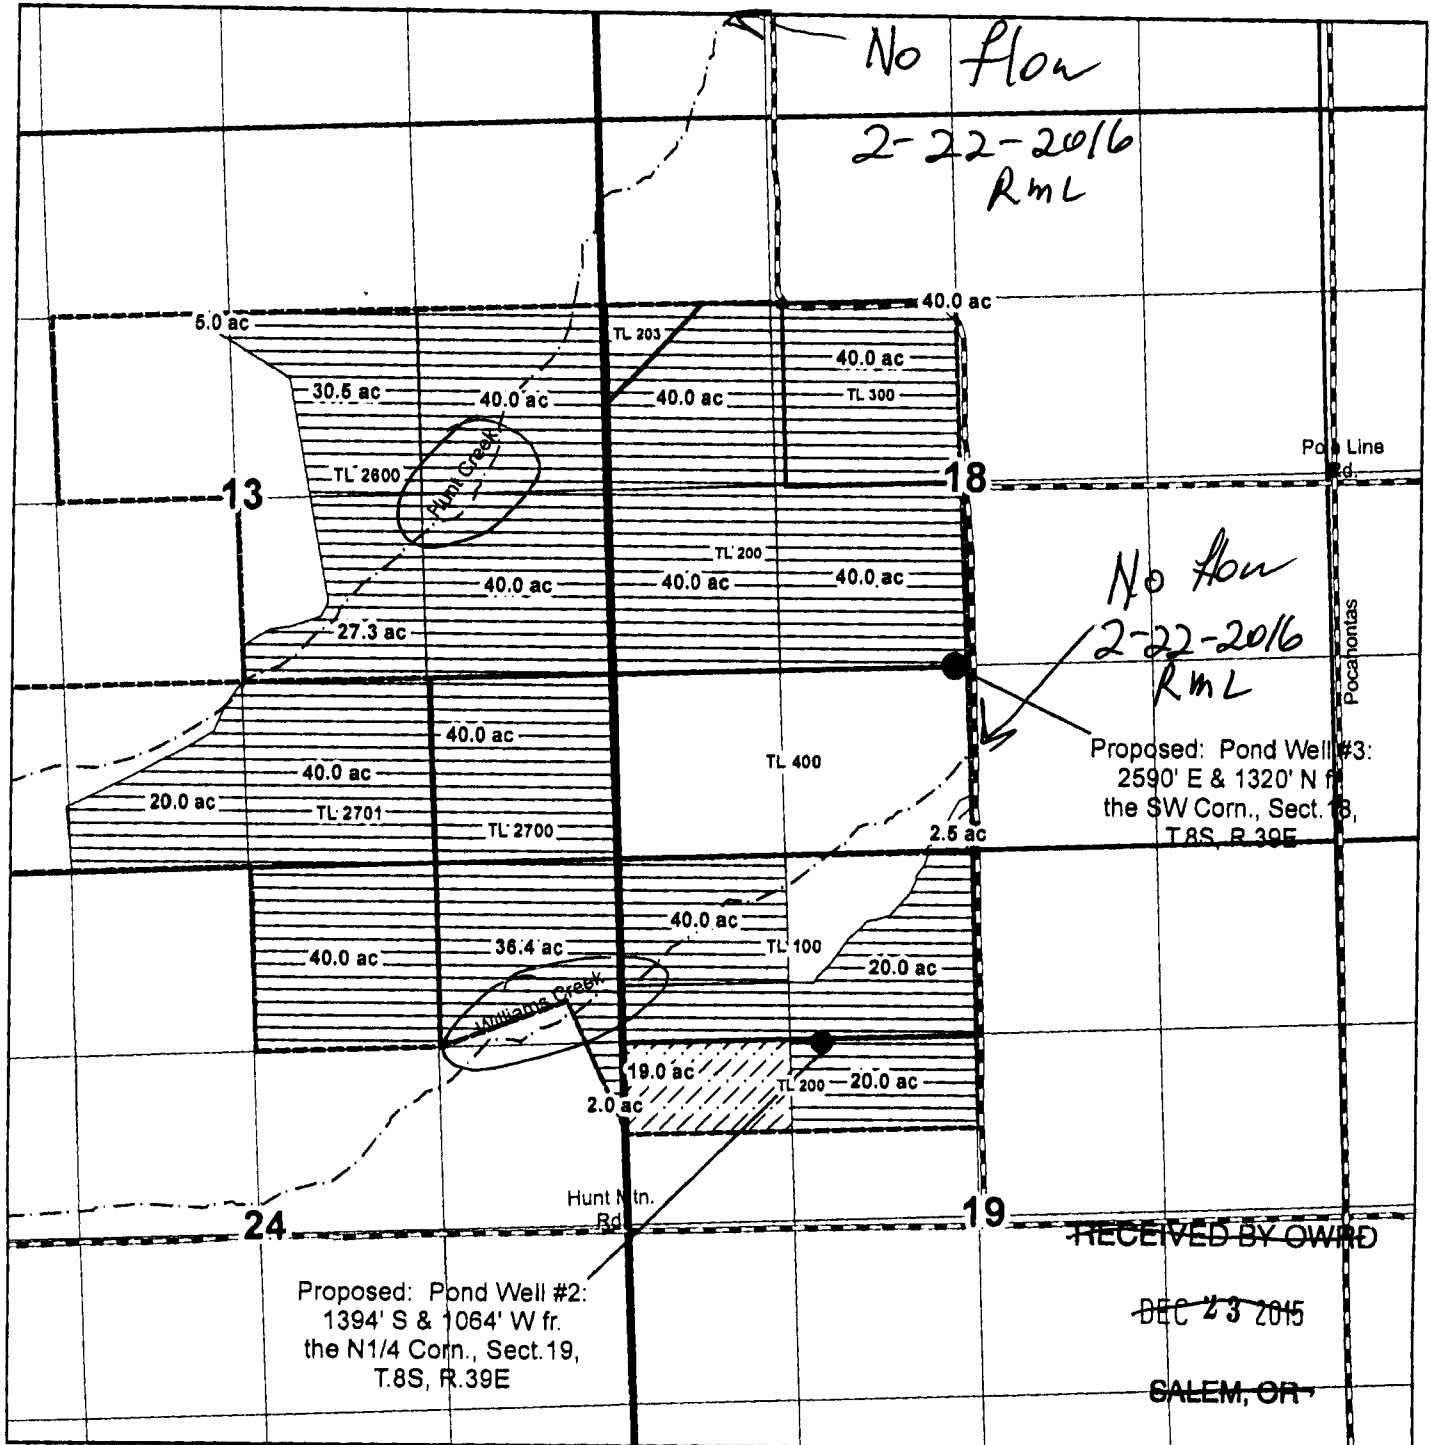

G. Kern