



Jon Beck Groundwater Application for 28.52 Acres of Nursery Use SE/NE 38S-2W-8-tax lot 100

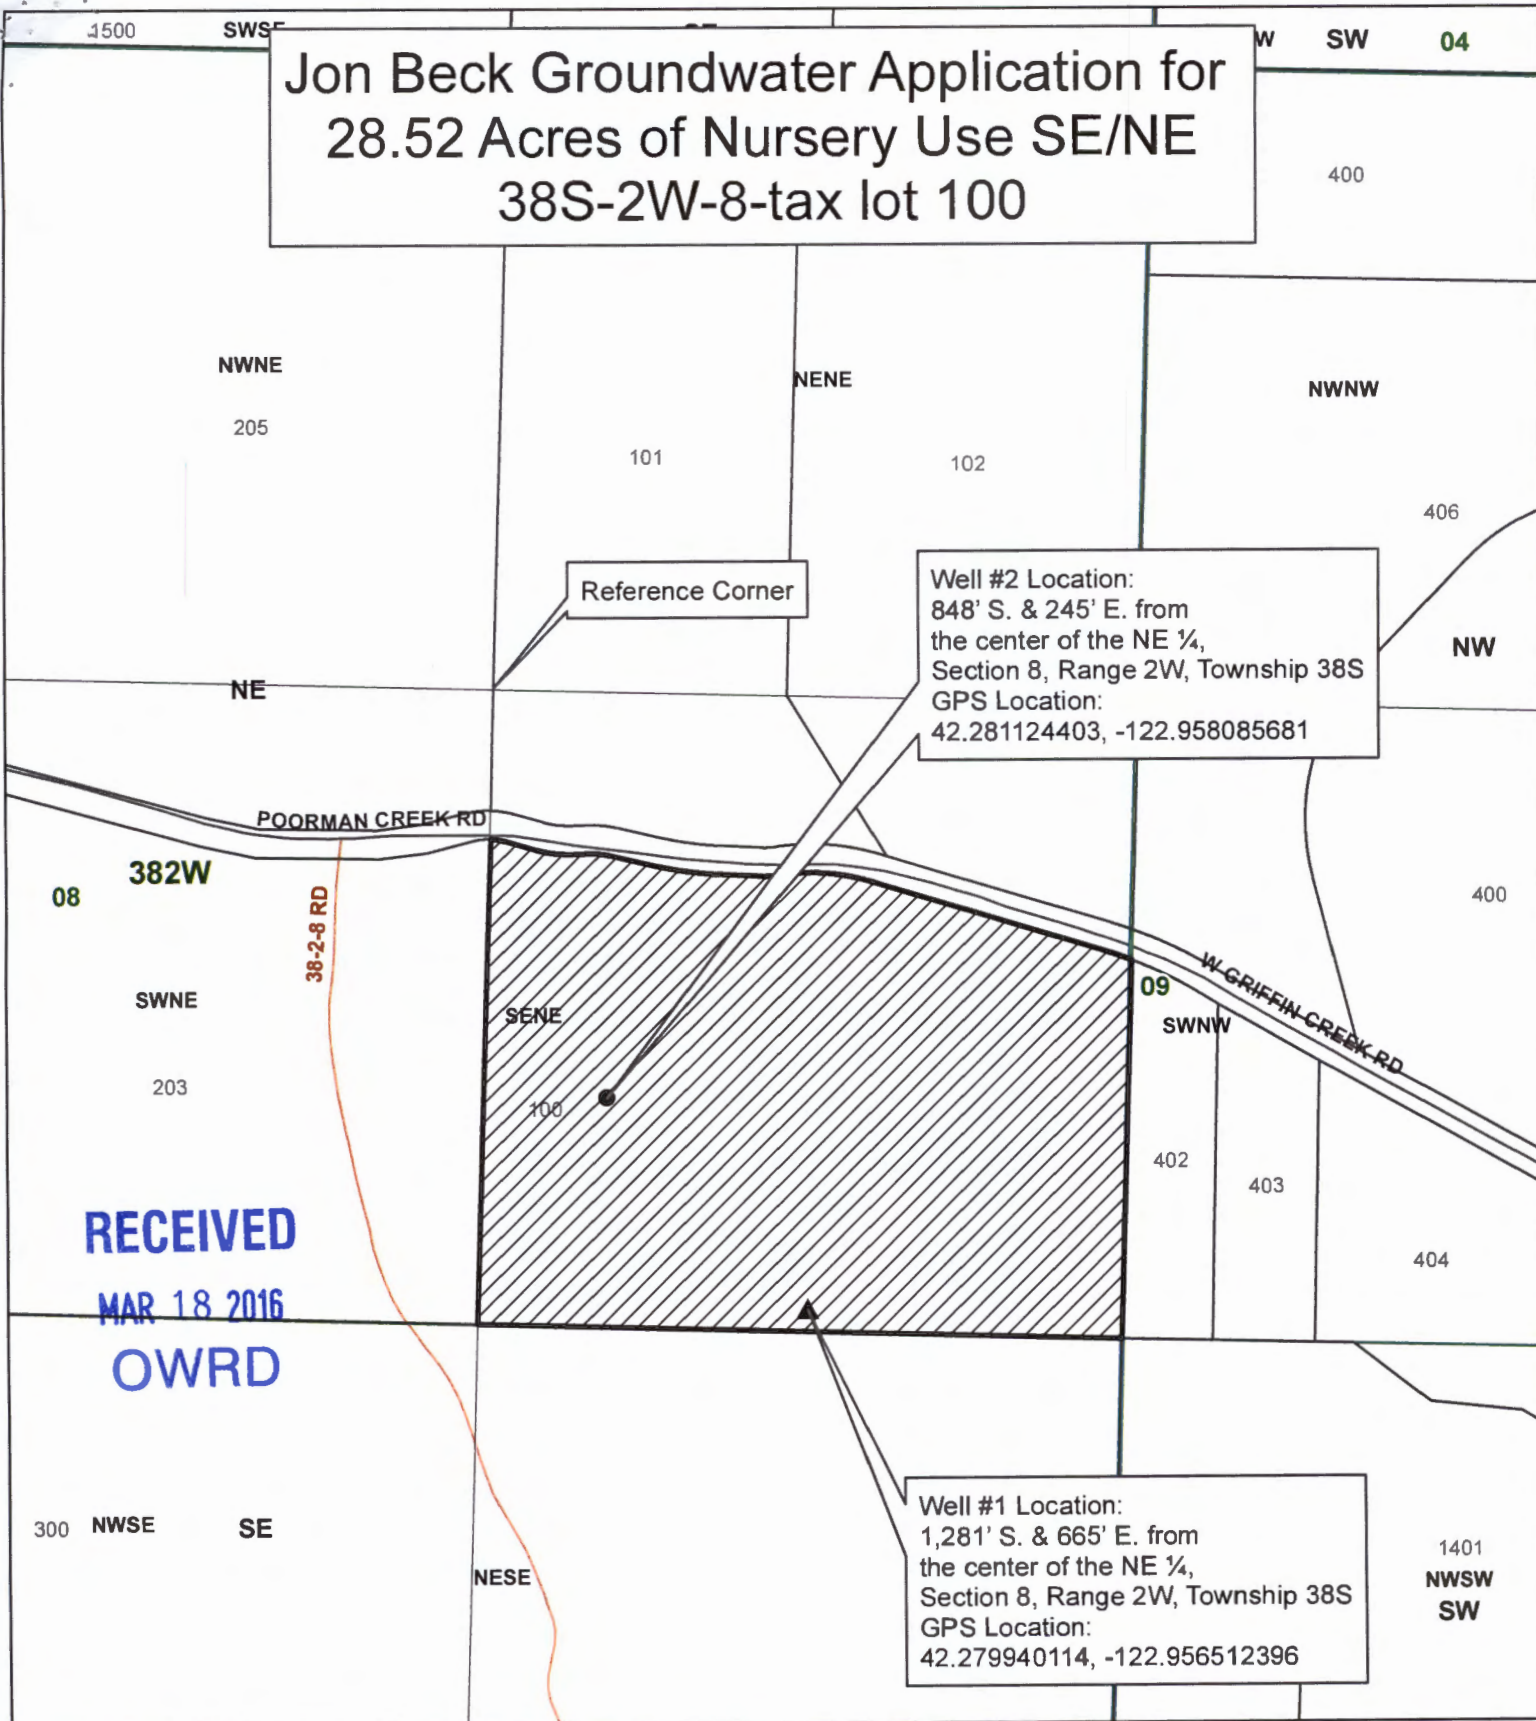

Legend

- ▲ Well 1
- Well 2
- Place of Use
- Taxlot 100
- Taxlots
- Townships
- Sections
- Quarter Sections
- Quarter Quarter Sections

1 inch = 400 feet

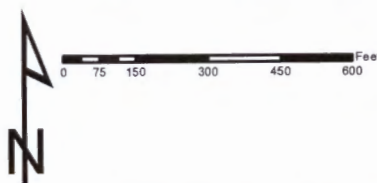

JACKSON COUNTY
WATERMASTER

Prepared by Travis Kelly

This map is based on a digital database compiled by Jackson County from a variety of sources. Jackson County cannot accept responsibility for errors, omissions, or positional accuracy. There are no warranties, expressed or implied.

Date: 02/03/2016: 38S-2W-8-tax lot 100 Jon Beck.mxd kellyn