


51285



T3S R1E
Section 36, NE 1/4
Scale 1" = 500'

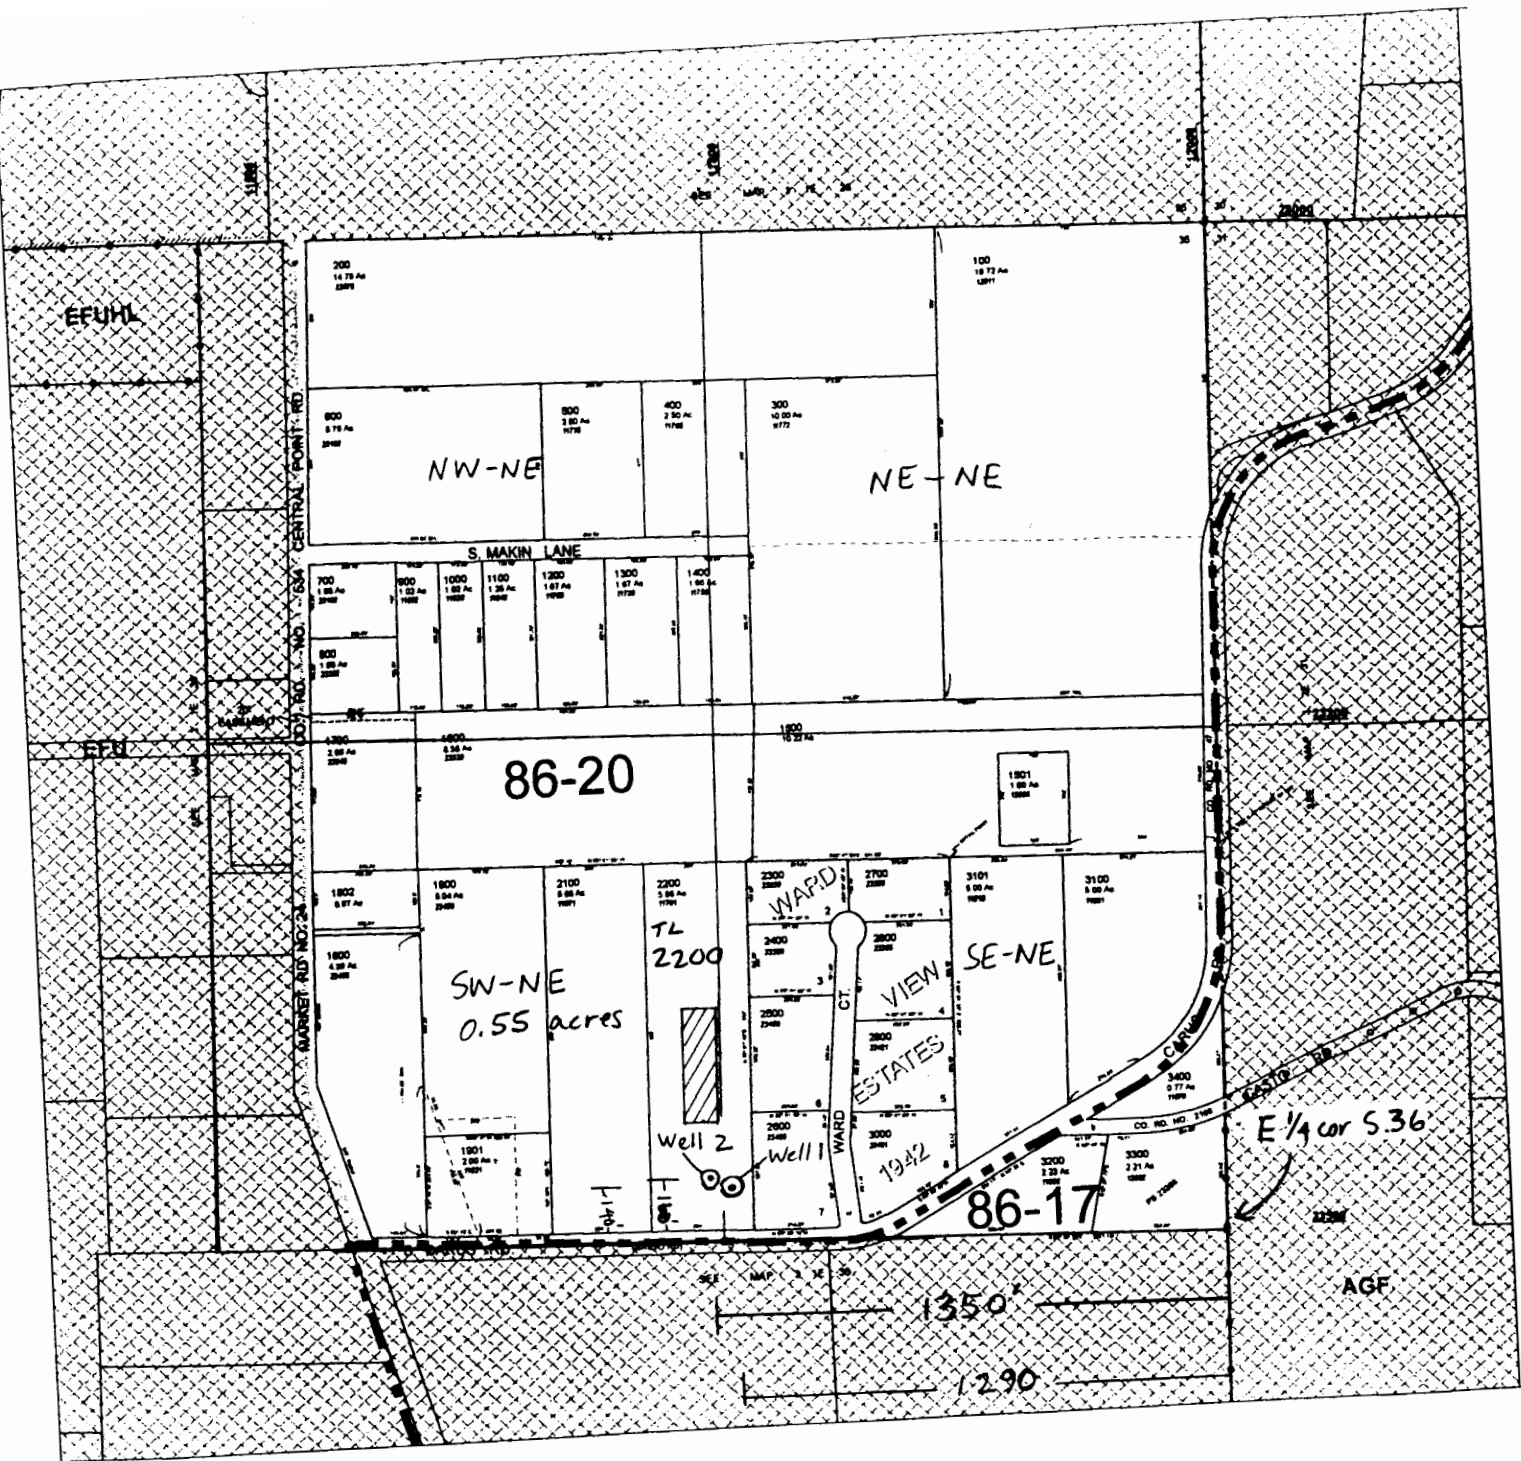

Well 1 is located
140' N 1290' W
Well 2 is located
160' N 1350' W
both from the E 1/4 cor
Section 36
1/4 Area to be irrigated

RECEIVED

MAR 18 2016

WATER RESOURCES DEPT
SALEM, OREGON