G-18272

TAX LOT 3401

EAST HALF OF BLOCK 89

SITUATED IN NW ¼, NW ¼ OF

SECTION 30,T1 NORTH, R10 EAST,

HOOD RIVER COUNTY

1" = 400'

RECEIVED BY OWRD

MAR 28 2016

SALEM, OR

3.5 ACRES
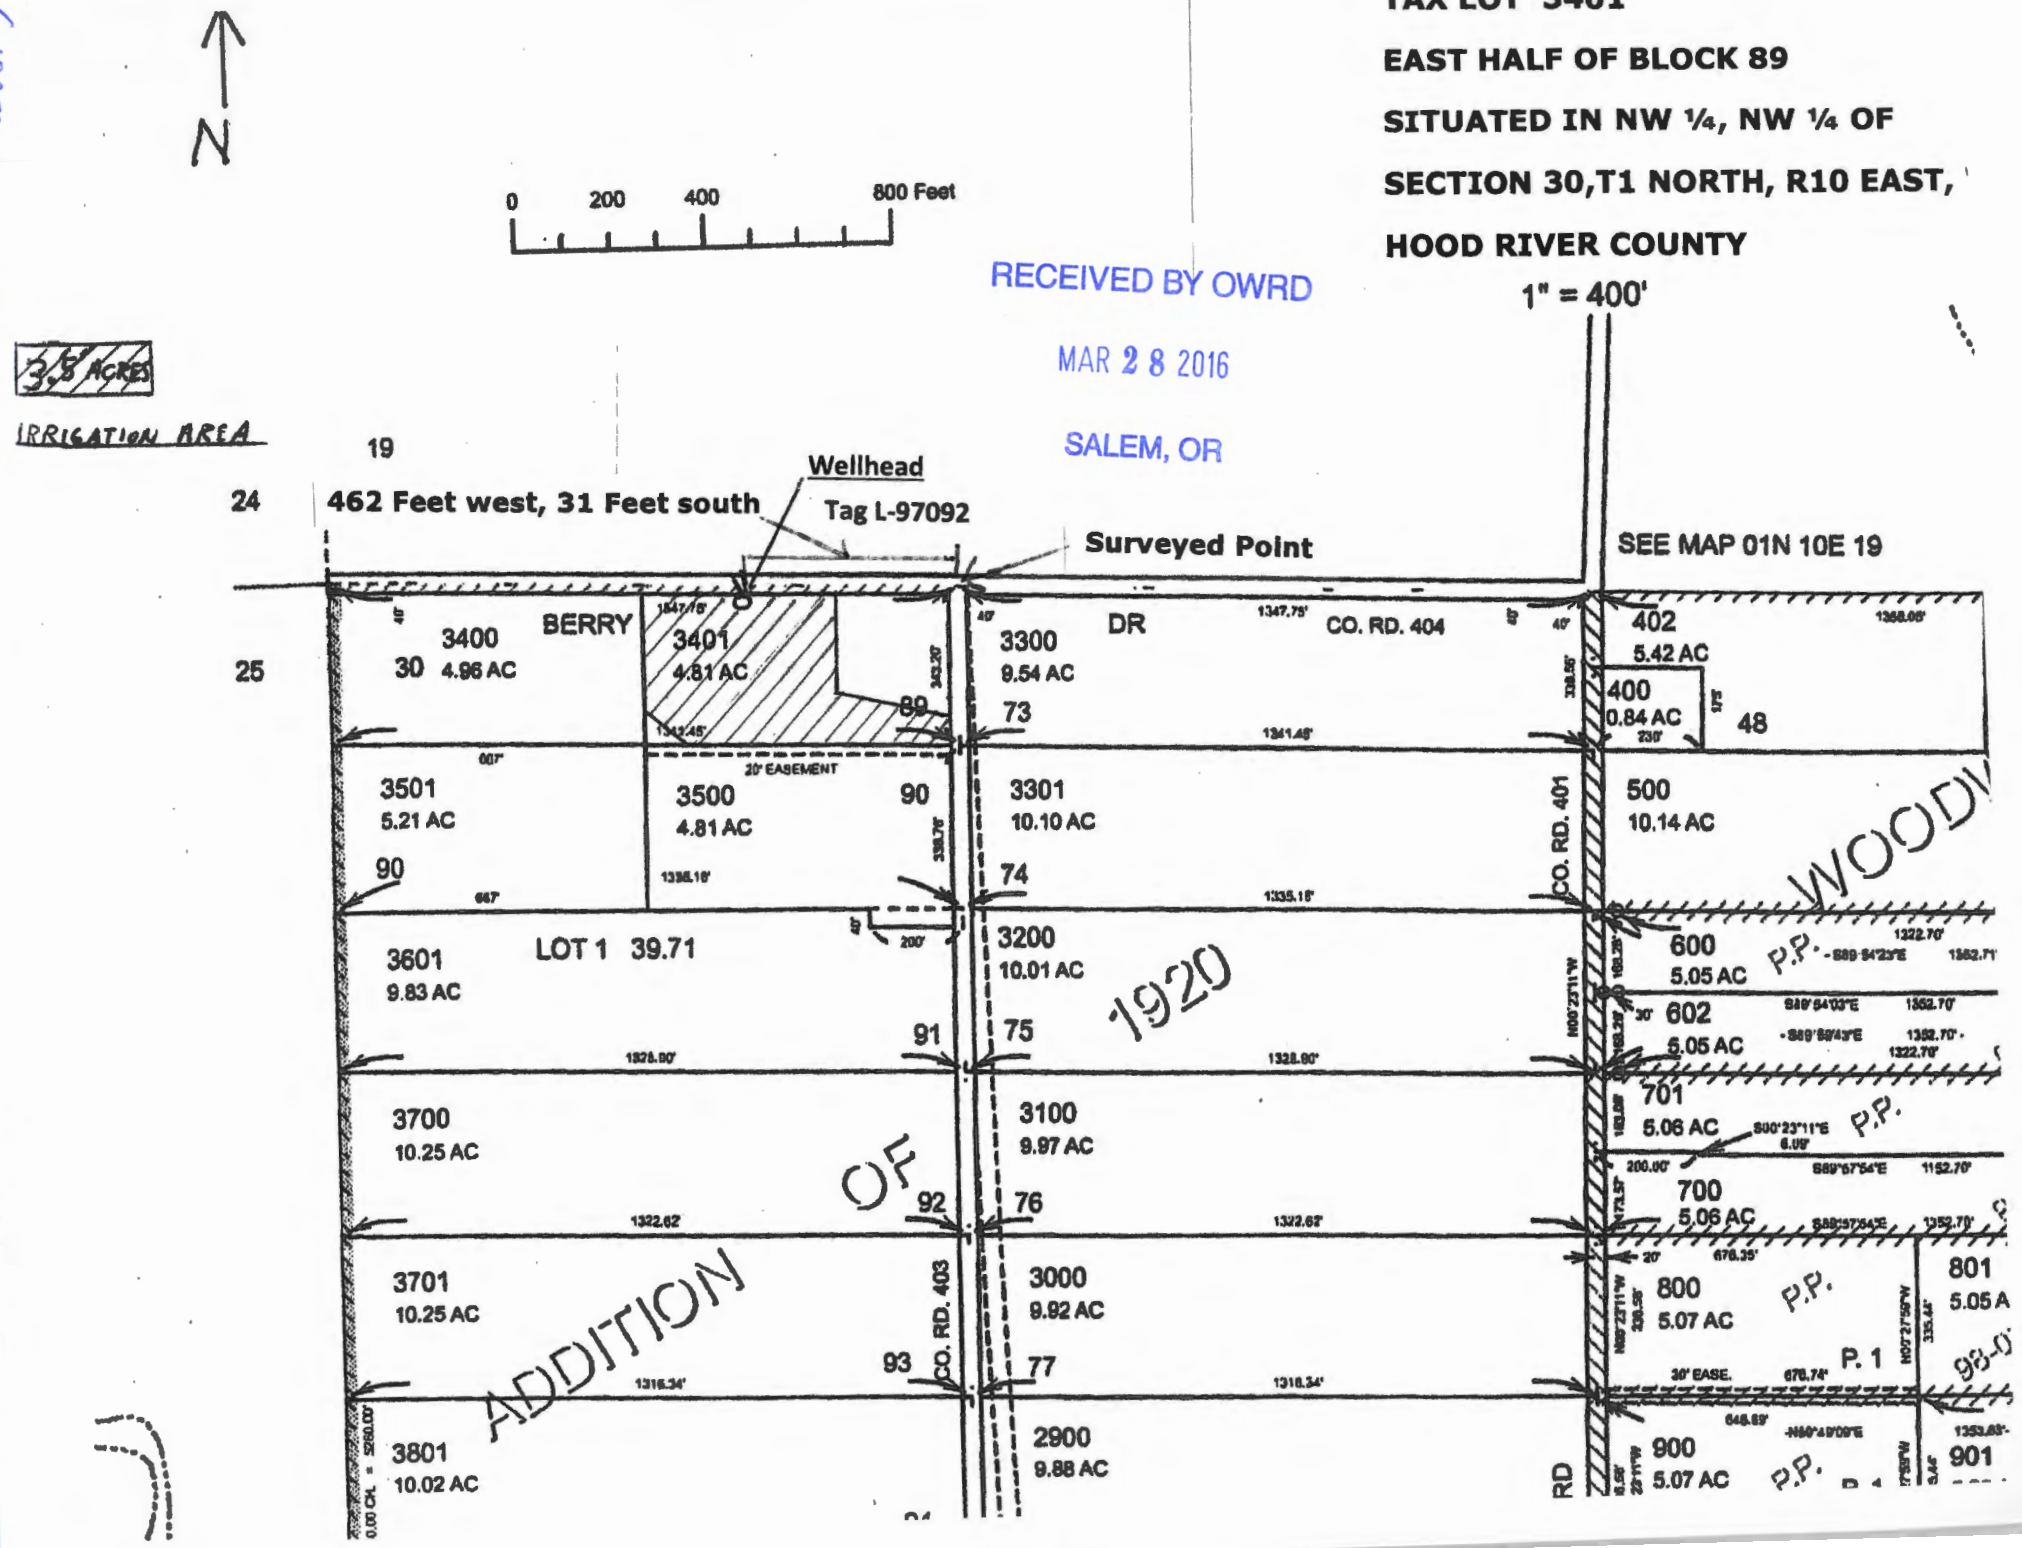
IRRIGATION AREA