

RECEIVED BY OW

SECTION PLAT

APR 04 2016


Section 16 Township 36 S Range 33 E

SALEM, OR

County of HARNEY State of ORE

☒ = Structures
⊕ = Well

↑
NORTH

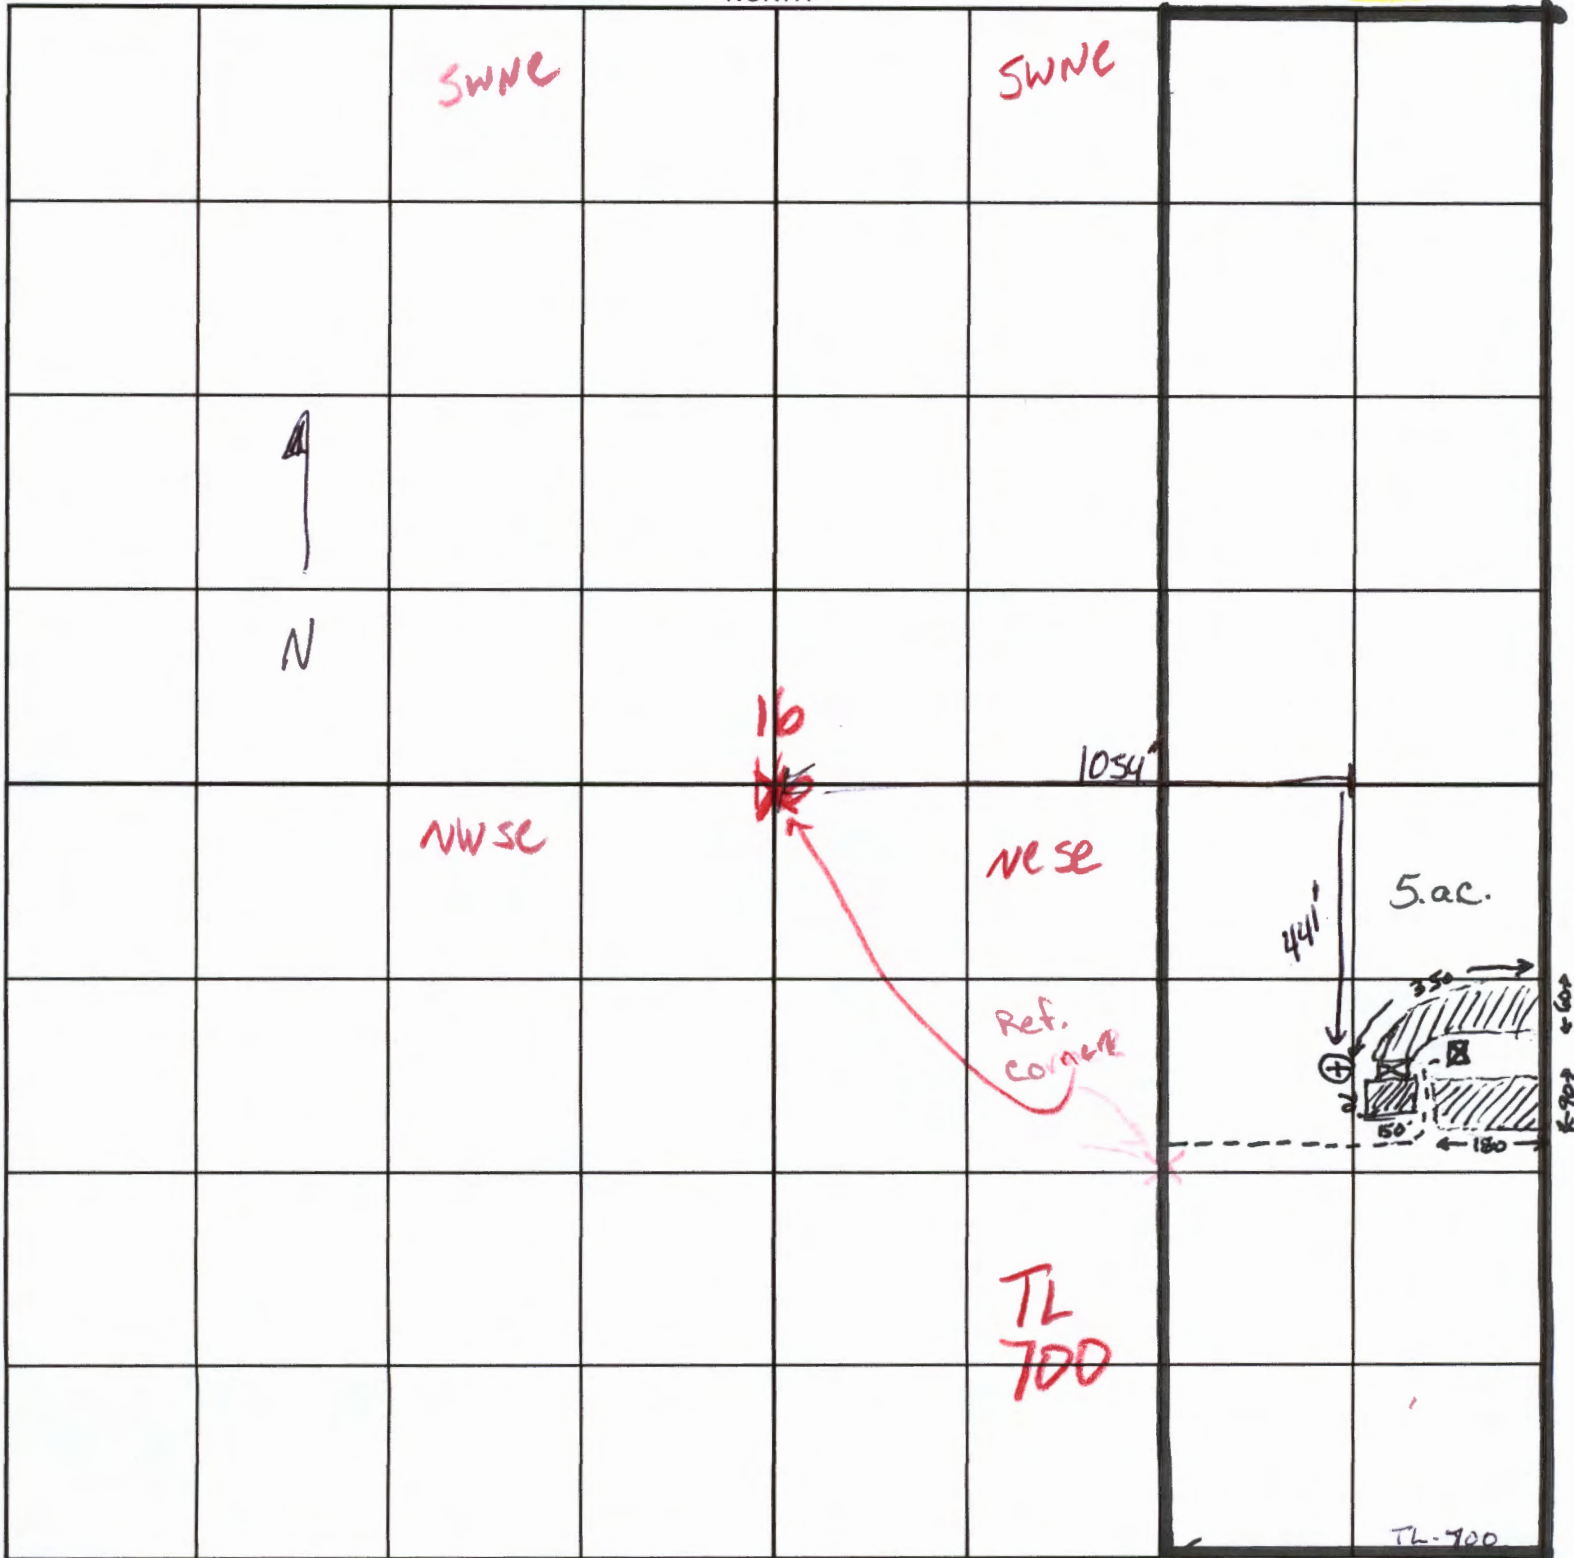

Property owner - Roy W Miller P.O. Box 1046 Sisters, OR 97759
4"=1 mile

G-18278

SALEM, OR

MAR 07 2016

RECEIVED BY OW