


G-18275

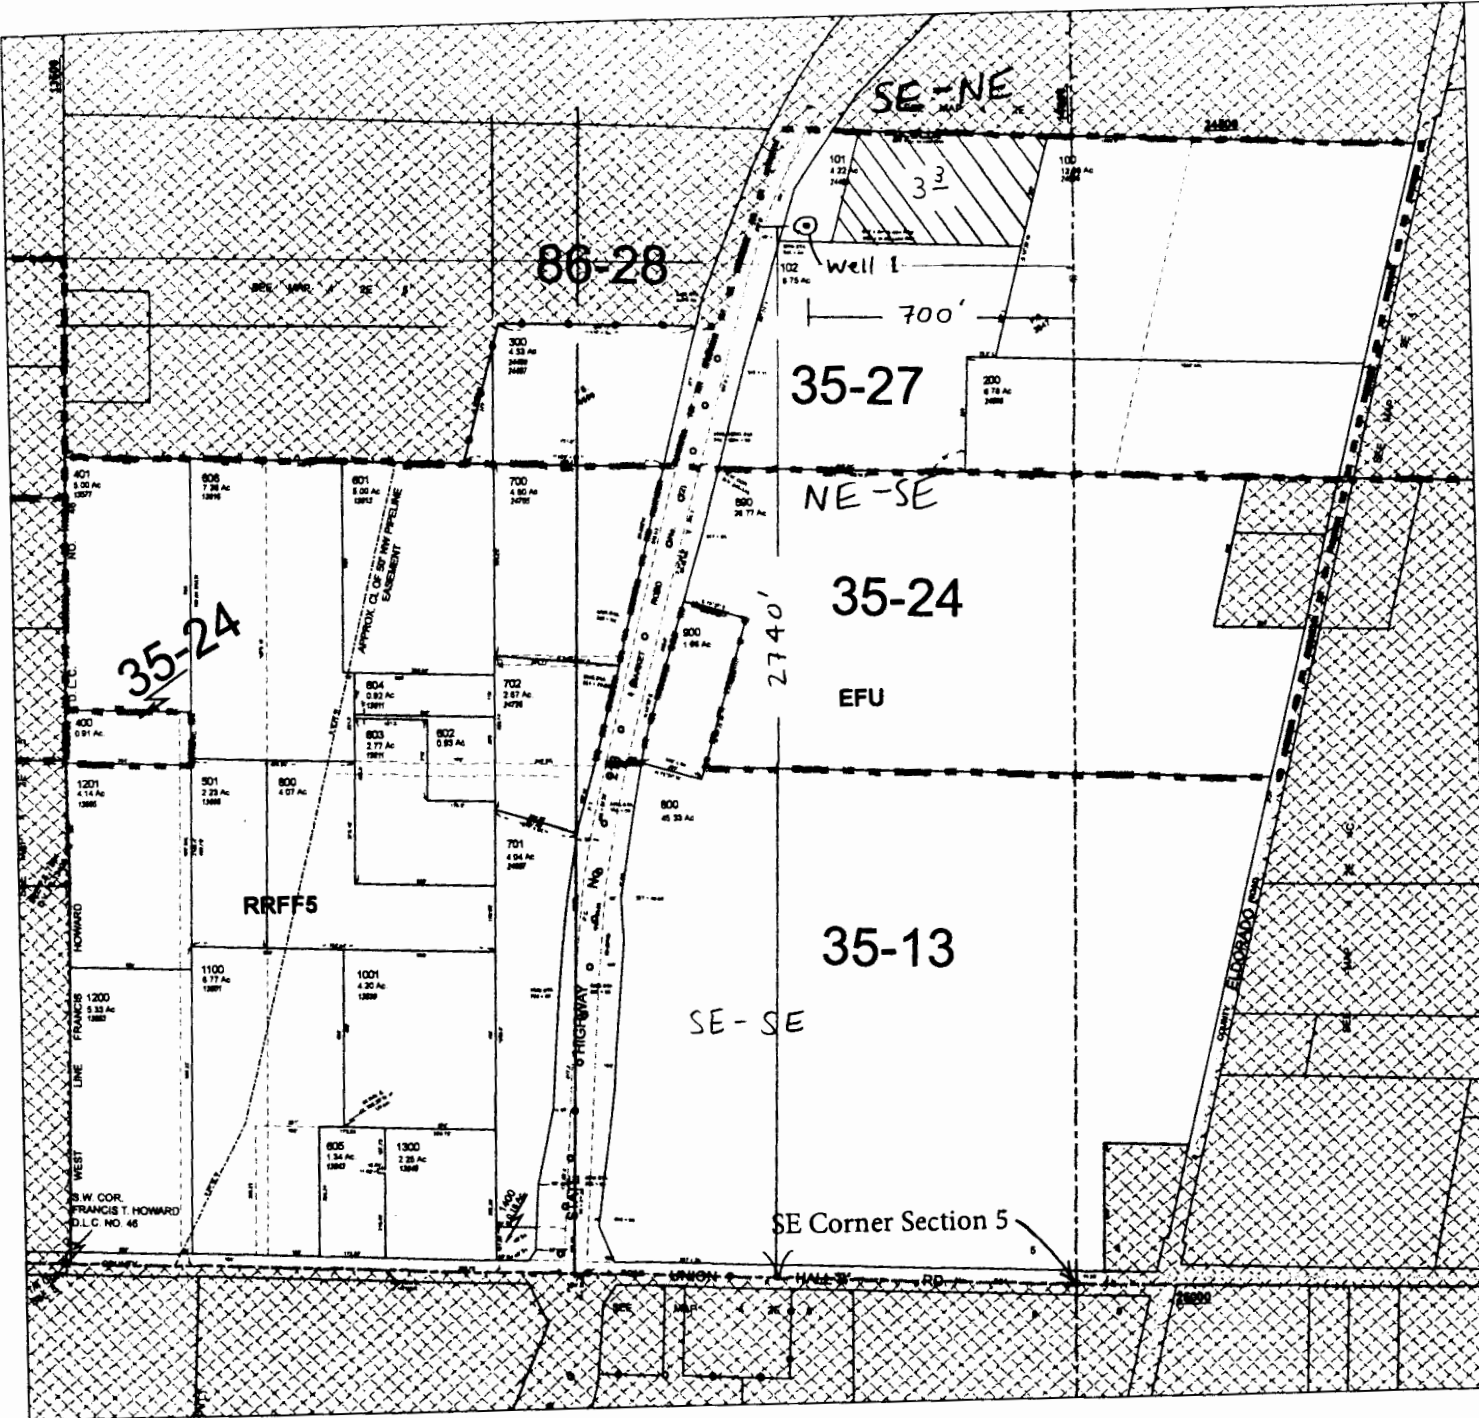

T4S, R2E Section 5

/// Area to be irrigated

⊙ Well 1

Well 1 located:
2740' N, 700' W
from the SE corner
Section 5

Scale 1" = 500'

PROG. 2015

APR 09 2015

SALEM, OR

