


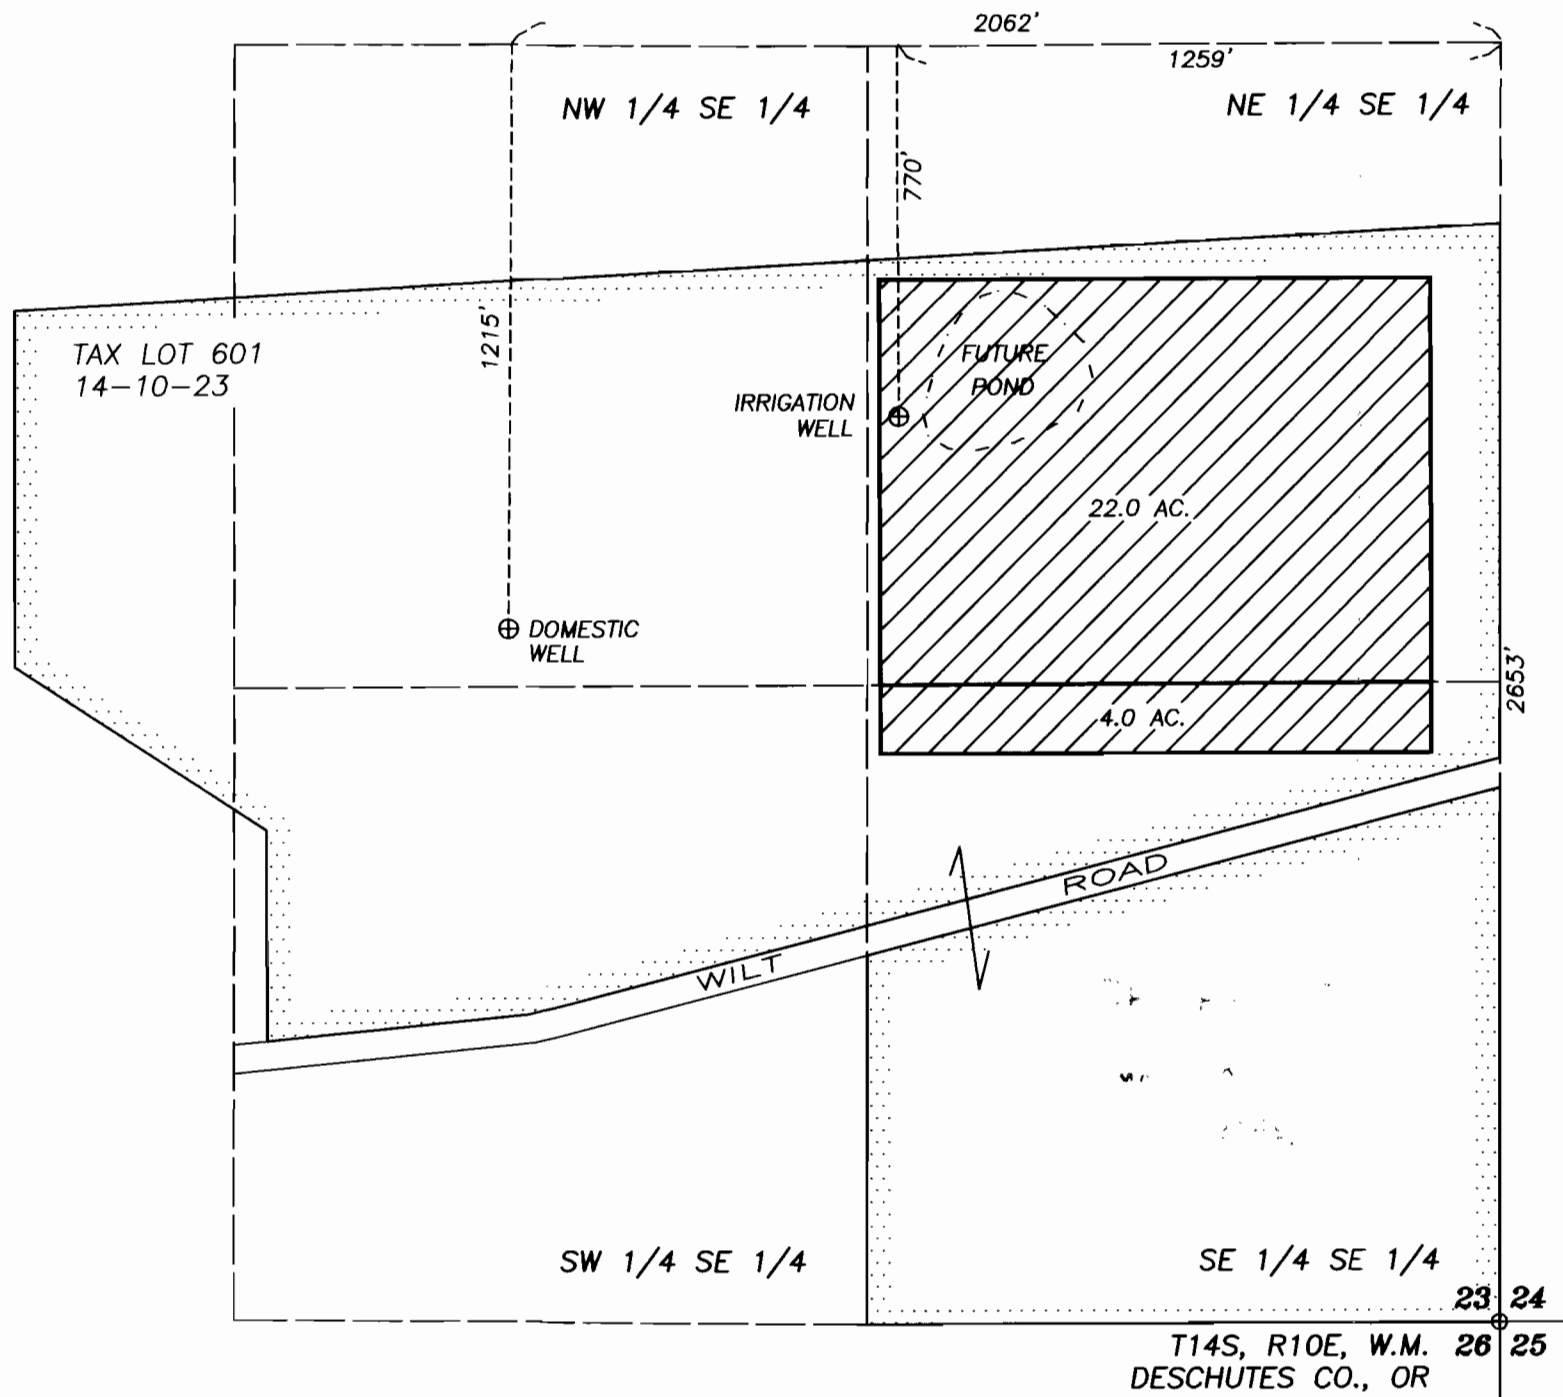

FINAL PROOF SURVEY




CLAIM OF BENEFICIAL USE

APPLICATION NO. G-14633
PERMIT NO. G-13442

IN THE NAME OF BRUCE SLAYDEN



IRRIGATED AREA

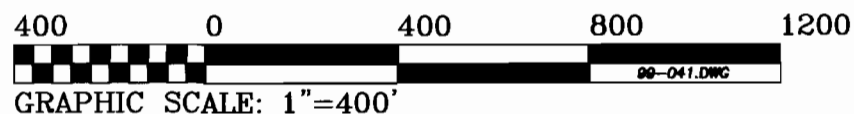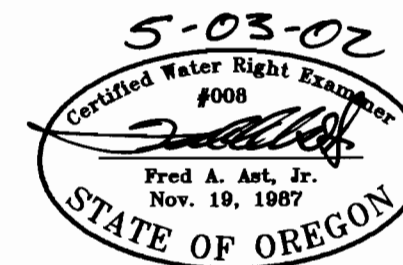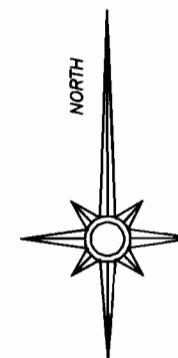

THIS MAP IS FOR THE PURPOSE OF IDENTIFYING THE LOCATION OF THE WATER RIGHT.
IT IS NOT INTENDED TO PROVIDE LEGAL DIMENSIONS OR LOCATIONS OF PROPERTY
OWNERSHIP LINES.