


RECEIVED

APR 14 2016

T36S R6W Northeast Quarter Section 29

WATER RESOURCES DEPT
SALEM, OREGON

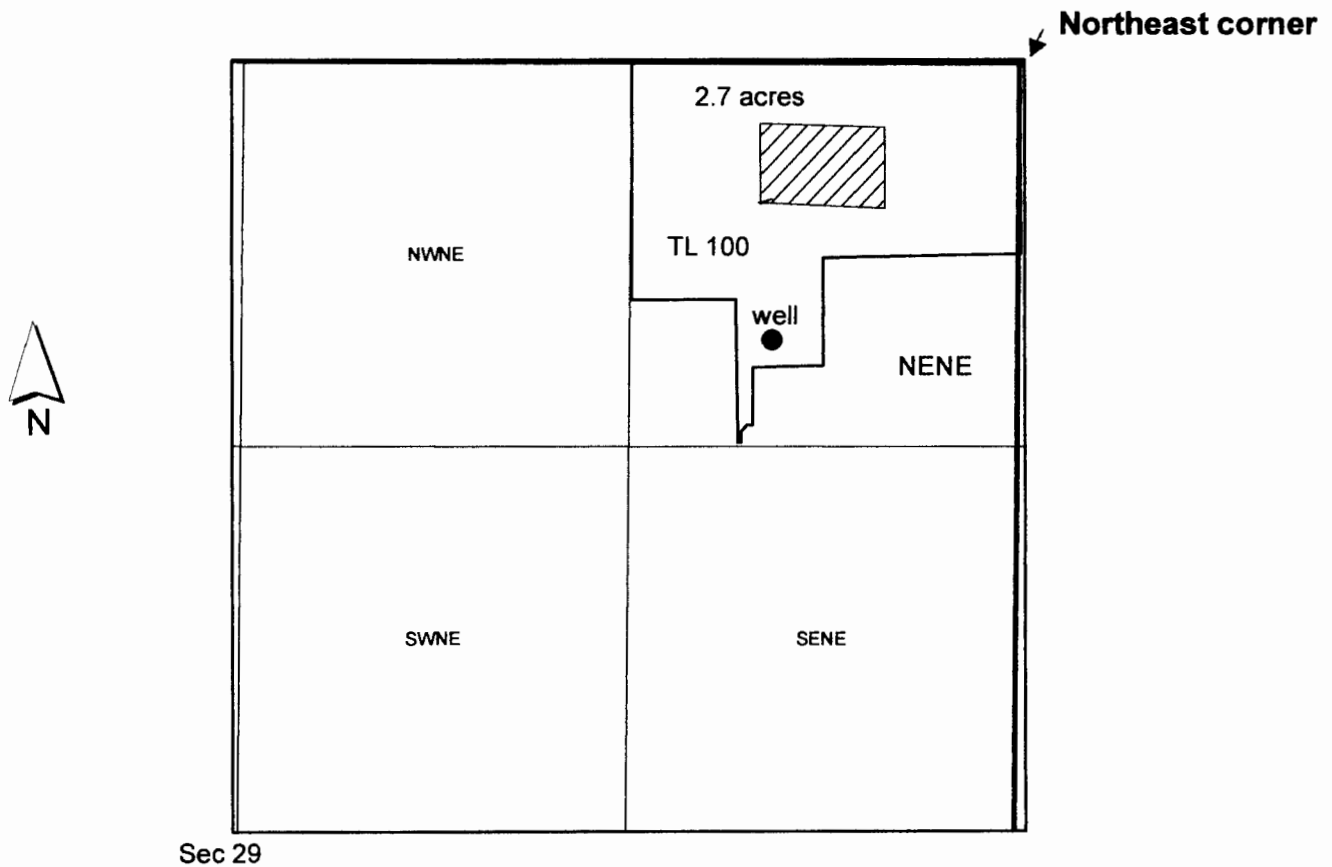

1 inch = 660 feet

The well is approximately 839 ft west and 964 ft south from the northeast corner of Section 29, per owner.