


RECEIVED BY OWRD

APR 1 2016

SALEM, OR

2N/2W-11

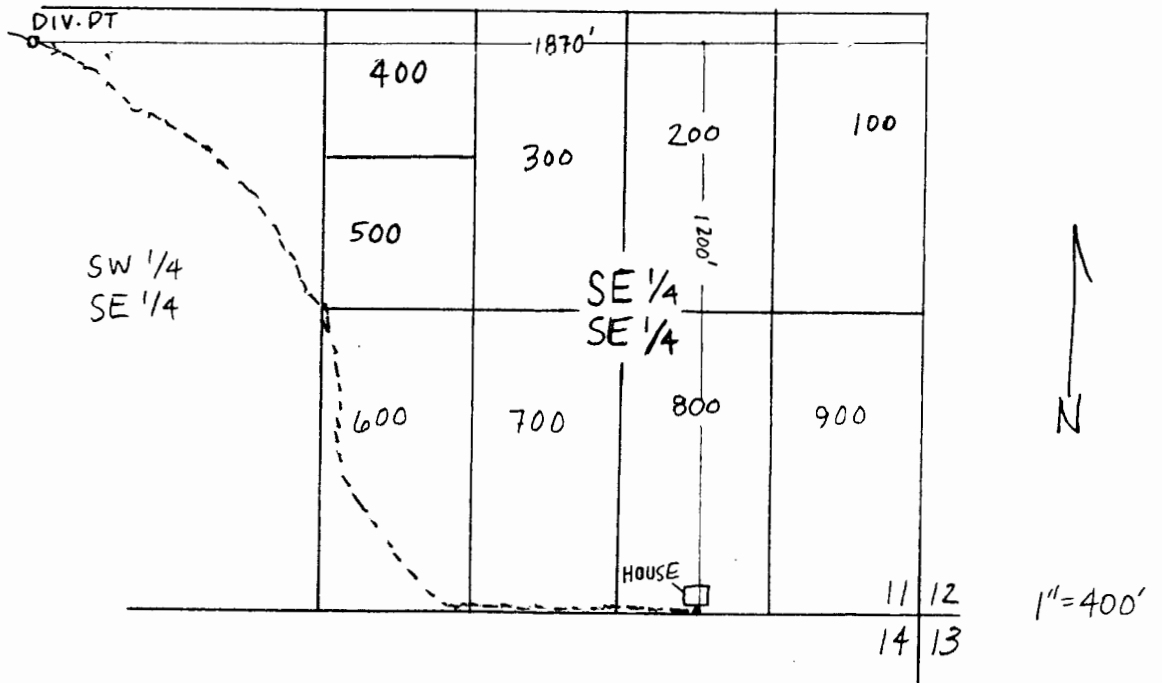

POD is located 1200' N, 1870' W
from SE corner Section 11

RECEIVED BY OWRD

MAR 02 2016

SALEM, OR

S-88214