


# T35S R7W Northeast Quarter Section 14

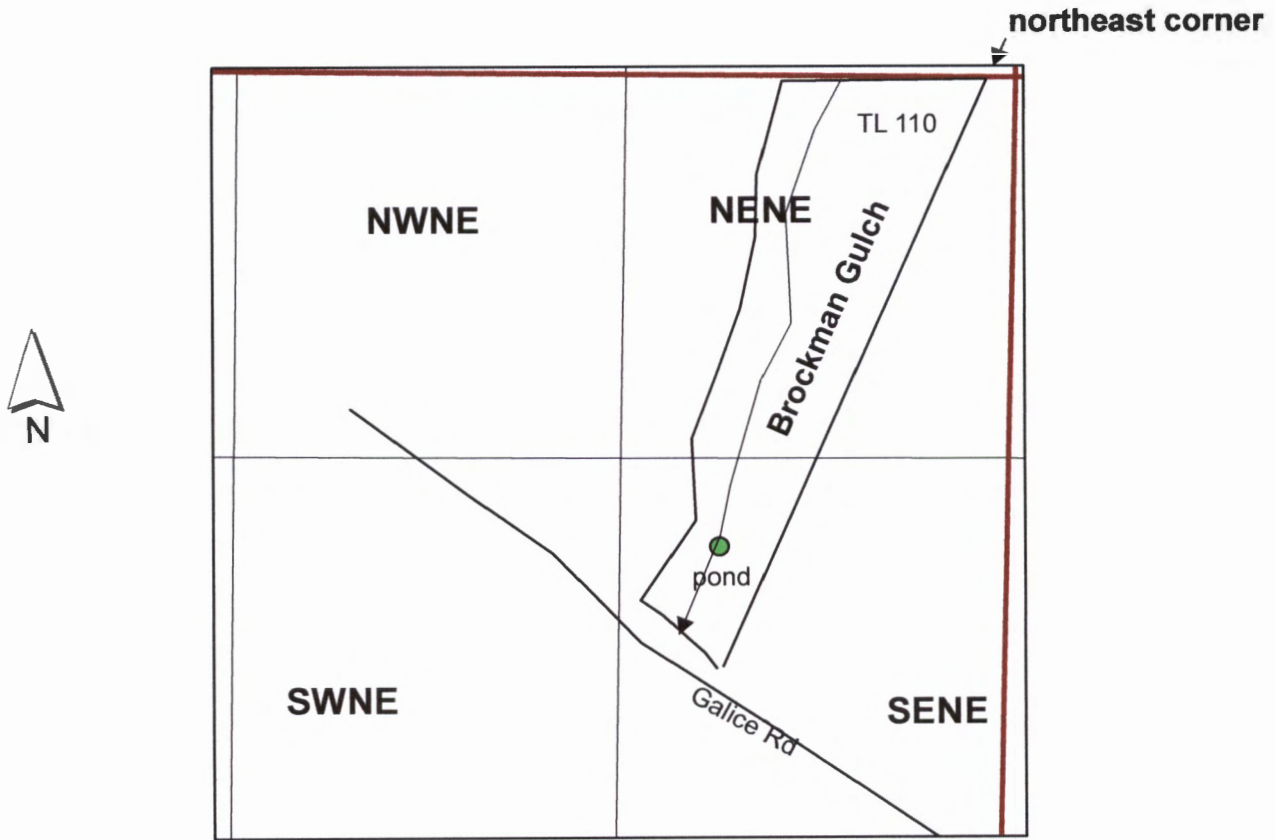

1 inch = 660 feet

The pond is 1615 ft south and  
973 ft west from the northeast corner.

RECEIVED BY OWRD

APR 19 2016

SALEM, OR

R-0023