


T40S R8W Southeast Quarter Section 27

RECEIVED BY OWRD

APR 20 2016

SALEM, OR

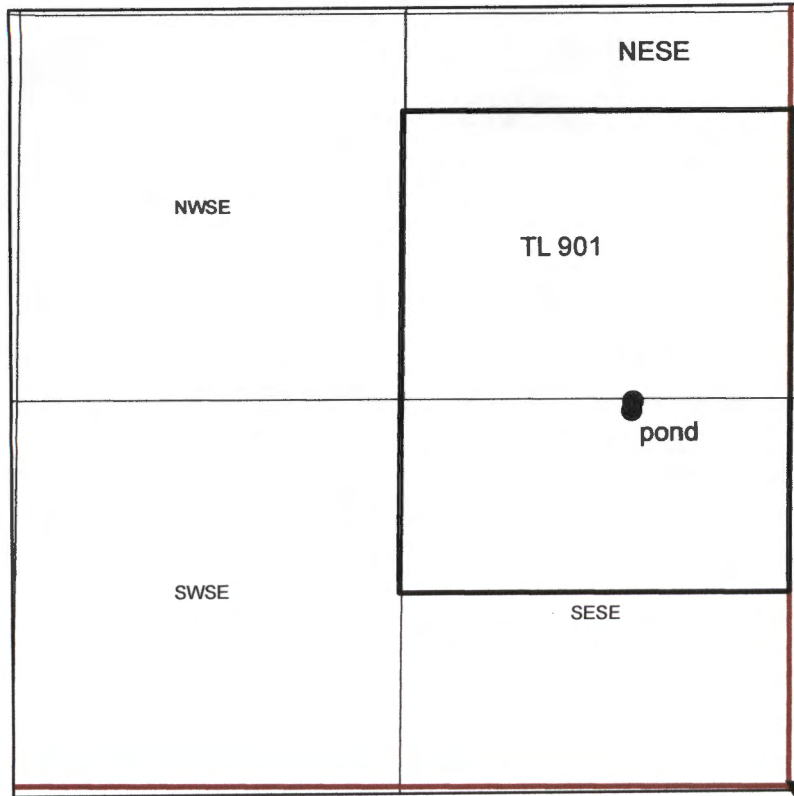

southeast corner

1 inch = 660 feet

The pond is located 528 ft west and 1315 ft north from the southeast corner Section 27.

R-90215