
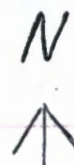



# Map *Top 15s R3w Sec 21 & 28*

RECEIVED BY OWRD  
MAY 02 2016  
SALEM, OR

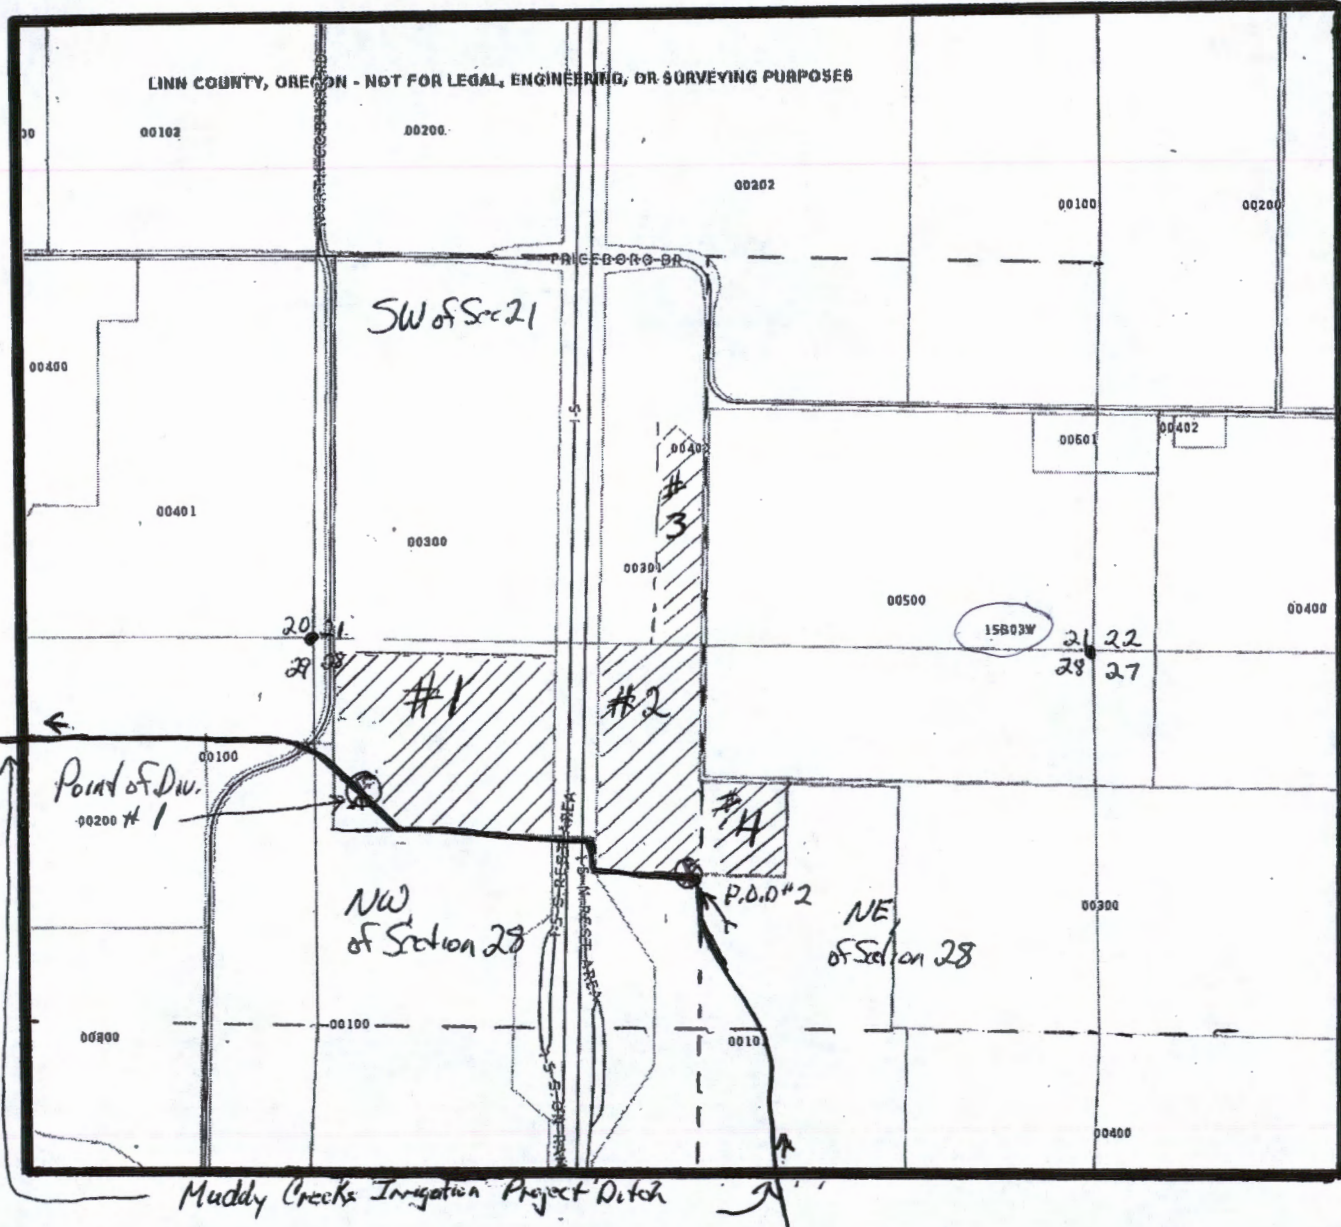

Richard D. Baker  
32283 Diamond Hill Dr  
Harrisburg, OR 97446-9738

- #1 NW of NW Sec 28 15s R3w TL300  
33 acres
- #2 NE of NW Sec 28 15s R3w TL301  
23 acres
- #3 SE of SW Sec 21 15s R3w TL301  
7 acres
- #4 NW of NE Sec 28 15s R3w TL301  
7 acres

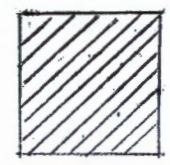

Water use area

Scale 1" = 1320'

Point of Diversion #1 ⊗  
1000' S  
300' W of NW corner  
of Section 28, Twp 15s R3w TL300

P.O.D # 2 ⊗  
1600' S.  
2640' W of NW corner  
of Sec. 28, Twp 15s R3w TL301

S-8821