

R-88824

1 = 400

CANCELLED
201
1300

SECOND STANDARD SEE MAP 8033300 PARALLEL NORTH

800 3.21 Ac
500 8.84 Ac
400 4.94 Ac
300 5.35 Ac
200 5.38 Ac
100 10.82 Ac
1/4 COR
C&G 2888
801 3.01 Ac
700 4.82 Ac
1
2
3
4
C&G 2489

NW
PL
NW

NE
NW

PL

COX COUNTY ROAD

802 3.03 Ac
803 9.73 Ac
800 1.38 Ac
15
14
13
1002 2.00 Ac
1000 4.88 Ac
1001 3.02 Ac
1700 8.60 Ac
801 3.28 Ac
16
1600 13.73 Ac
17
18
19
1100 9.48 Ac

VIEW

P.P. NO.

1998-38

P.G.E. TRANSMISSION LINE EASEMENT

BEAVER ALLSTON B.P.A.

SW
NW

3-06

SE
NW
AC
NW

SEE MAP 7830440

POND LOCATED
APPROX 1560' E &
80' N FROM THE
WEST 1/4 CORNER
OF SECTION 4
T 7 N, R 3 W

1500 11.91 Ac
1400 5.08 Ac
1302 4.42 Ac
1301 5.00 Ac
1200 9.48 Ac
30
20
20
POND
Dam

PLEASANT NW
SW
Last Revised:
05-27-11

SEE MAP 78304C0


NE
SW

MAY 04 2016
SALEM, OR

RECEIVED BY OWRD

RES

N ↑

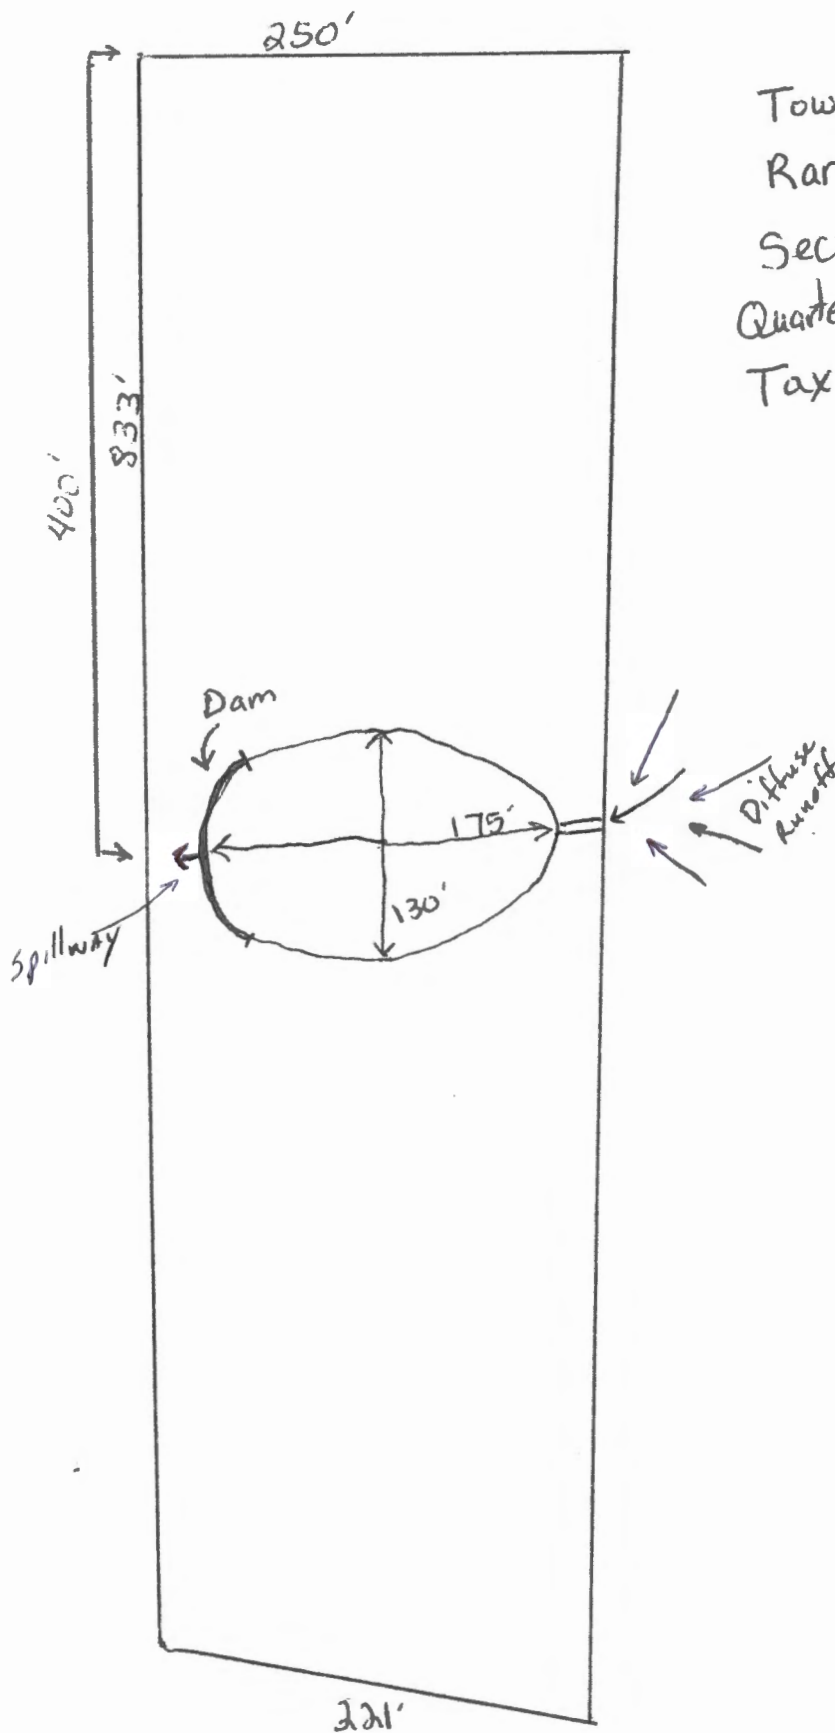

Township: T 7 N
Range : R 3 W
Section : 04
Quarter/Quarter: B/O
Tax Lot : 1400

RECEIVED BY OWRD

MAY 04 2016

SALEM, OR

Scale 1" = 100'

R-00224