


**COPY**

T. 35 S., R. 4 W., W.M.

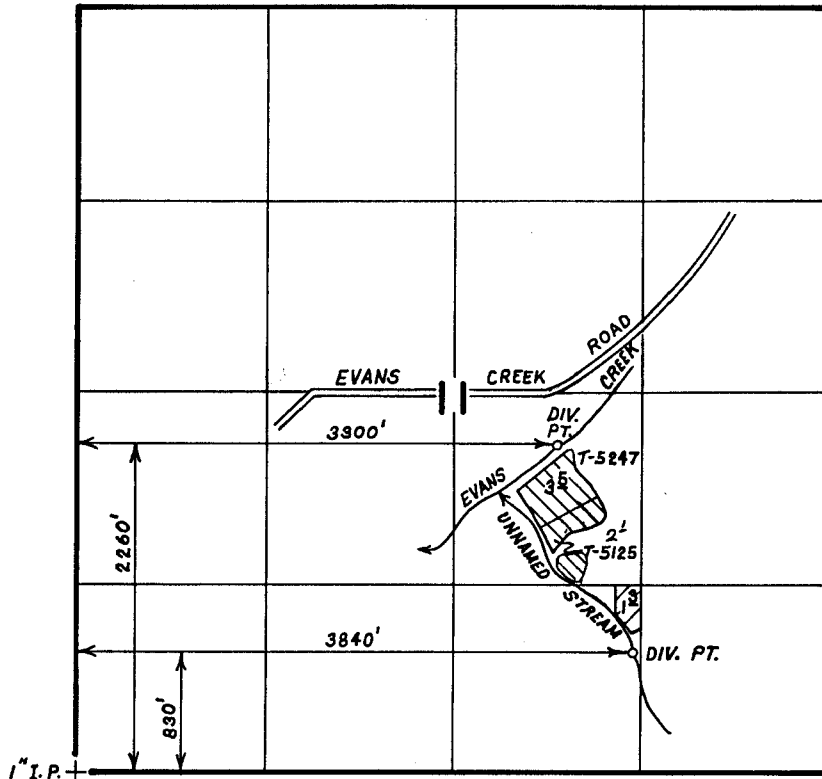

SCALE: 1" = 1320'

IRRIGATION from EVANS CREEK

IRRIGATION from UNNAMED STREAM

### FINAL PROOF SURVEY UNDER

TRANSFER NO. 5125 & 5247  
Application No. 50032 Permit No. 37614.....  
IN NAME OF


.....DANNY.....L.....RIIS.....

Surveyed DEC. 12. 1983., by B. S. JAMES.....  
Oct 26, 1987 B.S.J.




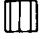
Map from A-58791

T. 35 S., R. 4 W., W.M.

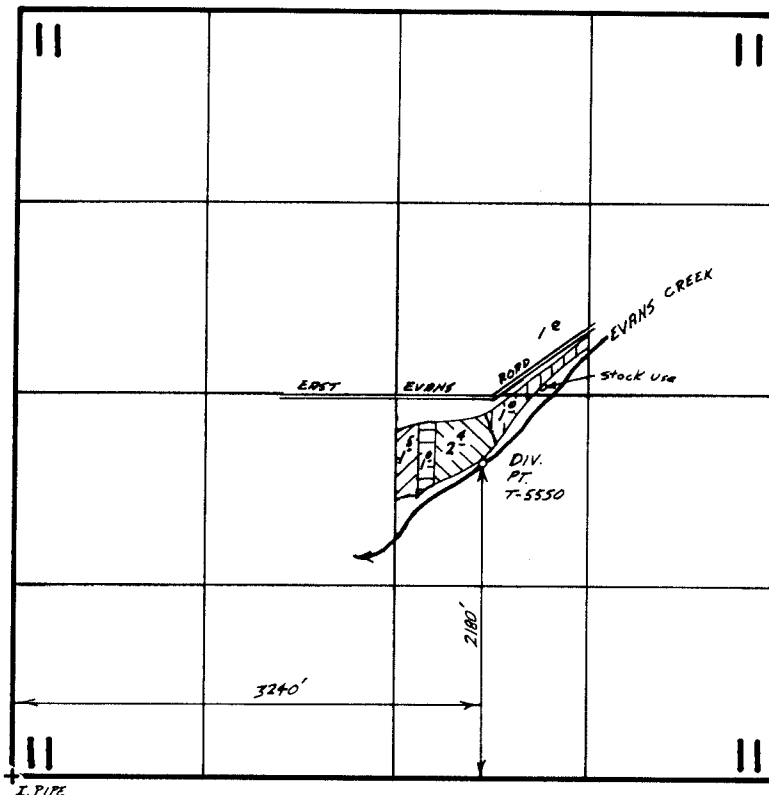**COPY**



Scale 1"=1320'

	Transfer	5248	2.4 ac
	"	5249	1.5 ac
	"	5250	1.0 ac
	Permit	44329	4.9 ac

**FINAL PROOF SURVEY**  
UNDER

Transfer No.'s 5248, 5249, 5250 & 5550  
Application No. 58791... Permit No. 44329....  
IN NAME OF

RICHARD & DONNA SHUCK

Surveyed Aug. 14... 19.85, by B.S. JAMES.....