



Oregon Water Resources Department
725 Summer Street NE, Suite A
Salem Oregon 97301-1266
(503) 986-0900
www.wrd.state.or.us

Certificate of Water Right Ownership Update

NOTICE TO SELLERS & BUYERS:

By law, all water belongs to the public (ORS 537.110). In almost every instance, a permit or water right certificate from the Water Resources Department is needed before using, diverting or storing water (ORS 537.130). However, most domestic wells do not require water rights. A certificate of water right stays with the land. In order to keep track of water right ownership, the Department requests that this form be submitted to the Department. *If for multiple rights, a separate form for each right will be required.*

Water that has been used for a long time in one place or that involves a water structure (like a dam) that already exists is no guarantee that there is a water right which would allow the water use to continue.

If you have any questions about this form or water right requirements, please contact your local watermaster or call the Water Resources Department at 503-986-0900.

Note: Please type or print legibly when filling in the following information. Use additional paper if necessary.

PROPERTY SELLER INFORMATION

Applicant(s): Pat Burtie Mary L. Burtie

Mailing Address: 35060 Skort Corner Road

Ex Oregon 97856

Phone: 541-421-3028 509-929-3366

PROPERTY BUYER INFORMATION

RECEIVED BY OWRD

Applicant(s): Joseph Burtie

Mailing Address: Box 468

Long Creek Oregon 97856

Phone: 541-421-3066

PROPERTY DESCRIPTION (attach additional pages if necessary):

County: Grant Township: _____ Range: _____ Section: _____

Tax Lot Number(s): _____

Street address of water right property: 35060 Skort Corner Road

Water Right Information (attach copy of water right permit or certificate & final proof map):

Application #: _____ Permit #: _____ Certificate or Page #: 39639

Will all the lands associated with this water right be owned by the buyer? ☐ Yes ☐ No

Name of individual completing this form: Pat and Mary L. Burtie Phone: 541-421-3028

Signature: Pat Burtie Mary L. Burtie Date: September 17, 2015

Please be sure to attach a copy of your property deed or legal description of the property.

STATE OF OREGON
COUNTY OF GRANT
CERTIFICATE OF WATER RIGHT

This Is to Certify, That SAVILLA TROWBRIDGE 97845

of Northwest 8th Street, John Day, State of Oregon, has made proof to the satisfaction of the STATE ENGINEER of Oregon, of a right to the use of the waters of a well

a tributary of Cohoe Creek for the purpose of supplemental irrigation of 260.1 acres

under Permit No. C-3499 of the State Engineer, and that said right to the use of said waters has been perfected in accordance with the laws of Oregon; that the priority of the right hereby confirmed dates from October 7, 1966

that the amount of water to which such right is entitled and hereby confirmed, for the purposes aforesaid, is limited to an amount actually beneficially used for said purposes, and shall not exceed 0.45 cubic foot per second

or its equivalent in case of rotation, measured at the point of diversion from the stream. The point of diversion is located in the SE $\frac{1}{4}$ SE $\frac{1}{4}$, Section 11, T. 11 S., R. 29 E., W. M., Well located: 20 feet North and 1260 feet West from SW Corner, Section 11.

The amount of water used for irrigation, together with the amount secured under any other right existing for the same lands, shall be limited to one-eightieth of one cubic foot per second per acre, or its equivalent for each acre irrigated and shall be further limited to a diversion of not to exceed 3 acre feet per acre for each acre irrigated during the irrigation season of each year; provided further that the right allowed herein shall be limited to any deficiency in the available supply of any prior right existing for the same land and shall not exceed the limitation allowed herein,

and shall conform to such reasonable rotation system as may be ordered by the proper state officer.

A description of the place of use under the right hereby confirmed, and to which such right is appurtenant, is as follows:

39.0 acres NE $\frac{1}{4}$ SE $\frac{1}{4}$
22.8 acres NW $\frac{1}{4}$ SE $\frac{1}{4}$
0.3 acre SW $\frac{1}{4}$ SE $\frac{1}{4}$
35.2 acres SE $\frac{1}{4}$ SE $\frac{1}{4}$
Section 2

35.6 acres NE $\frac{1}{4}$ NE $\frac{1}{4}$
34.6 acres SE $\frac{1}{4}$ NE $\frac{1}{4}$
39.2 acres NE $\frac{1}{4}$ SE $\frac{1}{4}$
5.0 acres NW $\frac{1}{4}$ SE $\frac{1}{4}$
8.4 acres SW $\frac{1}{4}$ SE $\frac{1}{4}$
40.0 acres SE $\frac{1}{4}$ SE $\frac{1}{4}$

Section 11

T. 11 S., R. 29 E., W. M.

RECEIVED BY OWRD

SEP 21 2015

SALEM, OR

use of the water for the purposes aforesaid is restricted to the lands or place of use hereinafter described

WITNESS the signature of the State Engineer, affixed

this date. December 28, 1973

Chris L. Wheeler


State Engineer

Recorded in State Record of Water Right Certificates, Volume 31, page 39639

T. 11 S. R. 29 E. W.M.

39634

2

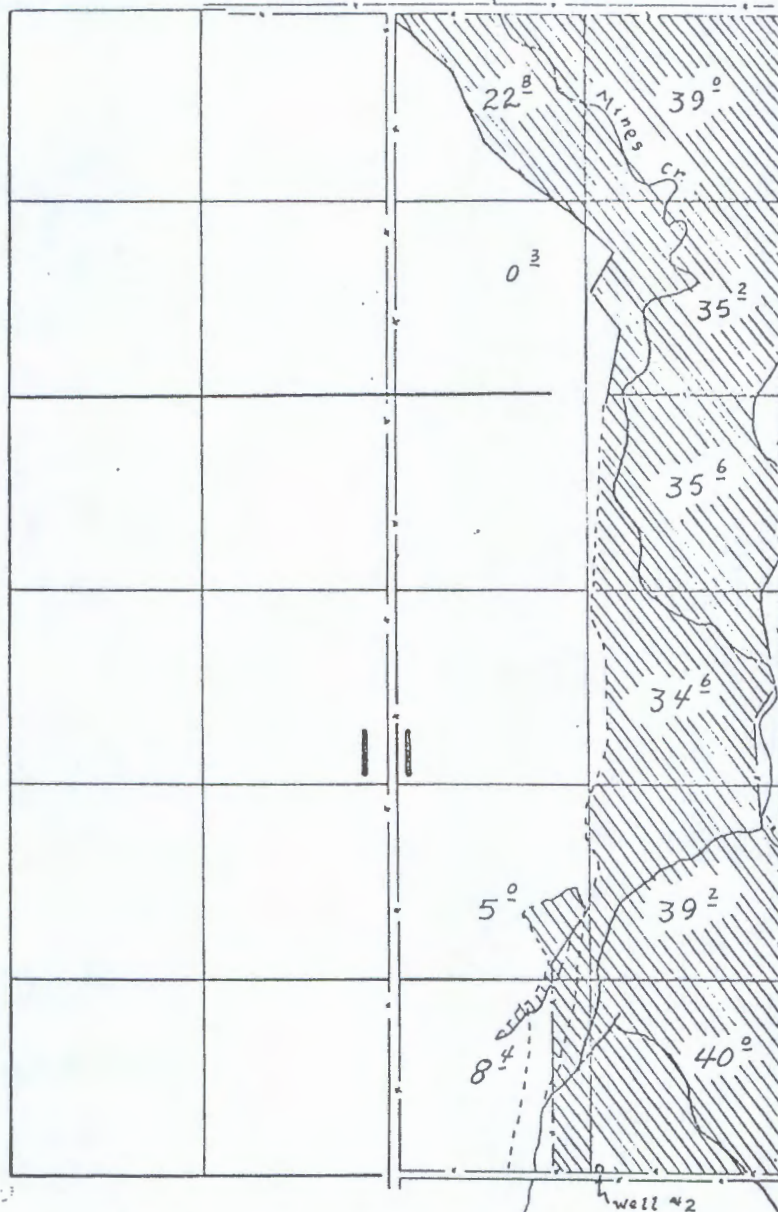

Well Loc. 20' N. & 1260' W. from S.W. Cor. Sec. 11

FINAL PROOF SURVEY
UNDER

RECEIVED BY OWRD

SEP 21 2015

SALEM, OR

Application No. G-3496 Permit No. G-3499

IN NAME OF

Savilla Trowbridge

Surveyed 10 Aug. 1972, by L.E. Gould