



Oregon Water Resources Department
 725 Summer Street NE, Suite A
 Salem Oregon 97301-1266
 (503) 986-0900
 www.wrd.state.or.us

Certificate of Water Right Ownership Update

NOTICE TO SELLERS & BUYERS:

By law, all water belongs to the public (ORS 537.110). In almost every instance, a permit or water right certificate from the Water Resources Department is needed before using, diverting or storing water (ORS 537.130). However, most domestic wells do not require water rights. A certificate of water right stays with the land. In order to keep track of water right ownership, the Department requests that this form be submitted to the Department. ***If for multiple rights, a separate form for each right will be required.***

Water that has been used for a long time in one place or that involves a water structure (like a dam) that already exists is no guarantee that there is a water right which would allow the water use to continue.

If you have any questions about this form or water right requirements, please contact your local watermaster or call the Water Resources Department at 503-986-0900.

Note: Please type or print legibly when filling in the following information. Use additional paper if necessary.

PROPERTY SELLER INFORMATION

Applicant(s): Sid and Karen DeBoer Foundation Db: Camp Low Echo LLC
First Last
 Mailing Address: 234 Vista Street
Ashland OR 97520
City State Zip
 Phone: 541-482-0915
Home Work Other

PROPERTY BUYER INFORMATION

Applicant(s): Ashland Family YMCA
First Last
 Mailing Address: 540 YMCA Way
Ashland OR 97520
City State Zip
 Phone: 541-482-9622
Home Work Other

RECEIVED BY OWRD
 OCT 13 2015
 SALEM, OR

PROPERTY DESCRIPTION (attach additional pages if necessary):

County: Klamath Township: 37 S., R. 5 E Range: 5 E., W. M. Section: 15
 Tax Lot Number(s): 5 (NE 1/4 SE 1/4)

Street address of water right property: 2001 North Keeneway Drive, Medford, OR 97504

Water Right Information (attach copy of water right permit or certificate & final proof map):

Application #: G 8491 Permit #: G 7997 Certificate or Page #: 48605

Will all the lands associated with this water right be owned by the buyer? Yes No

Name of individual completing this form: Ty Hisatomi Phone: 541-482-9622

Signature: Ty Hisatomi Date: October 7, 2015

Please be sure to attach a copy of your property deed or legal description of the property.

STATE OF OREGON

COUNTY OF KLAMATH

CERTIFICATE OF WATER RIGHT

This Is to Certify, That WINEMA GIRL SCOUT COUNCIL, INC.

of 2001 North Keeneway Drive, Medford, State of Oregon, 97501, has made proof to the satisfaction of the Water Resources Director, of a right to the use of the waters of a well

a tributary of Lake of the Woods for the purpose of domestic use in girl scout camp

under Permit No. G-7997 and that said right to the use of said waters has been perfected in accordance with the laws of Oregon; that the priority of the right hereby confirmed dates from February 1, 1978 that the amount of water to which such right is entitled and hereby confirmed, for the purposes aforesaid, is limited to an amount actually beneficially used for said purposes, and shall not exceed 0.05 cubic foot per second

or its equivalent in case of rotation, measured at the point of diversion from the well. The well is located in the Lot 5 (NE $\frac{1}{4}$ SE $\frac{1}{4}$), Section 15, T. 37 S., R. 5 E., W. M., 1600 feet North and 130 feet West from the SE Corner, Section 15

The amount of water used for irrigation, together with the amount secured under any other right existing for the same lands, shall be limited to ----- of one cubic foot per second per acre.

and shall conform to such reasonable rotation system as may be ordered by the proper state officer.

A description of the place of use under the right hereby confirmed, and to which such right is appurtenant, is as follows:

Lot 5 (NE $\frac{1}{4}$ SE $\frac{1}{4}$)
SE $\frac{1}{4}$ SE $\frac{1}{4}$
Section 15
T. 37 S., R. 5 E., W. M.

RECEIVED BY OWRD

OCT 13 2015

SALEM, OR

The right to the use of the water for the purposes aforesaid is restricted to the lands or place of use herein described.

WITNESS the signature of the Water Resources Director, affixed

this date. October 5, 1979

James E. Linn
Water Resources Director

G-7997


Application No. **G 8491** 48605

Permit No. G 7997

T.37S.,R.5E.,W.M.

RECEIVED
WATER RESOURCES DEPT.
SALEM, OREGON

Four mile c/c: Misc.

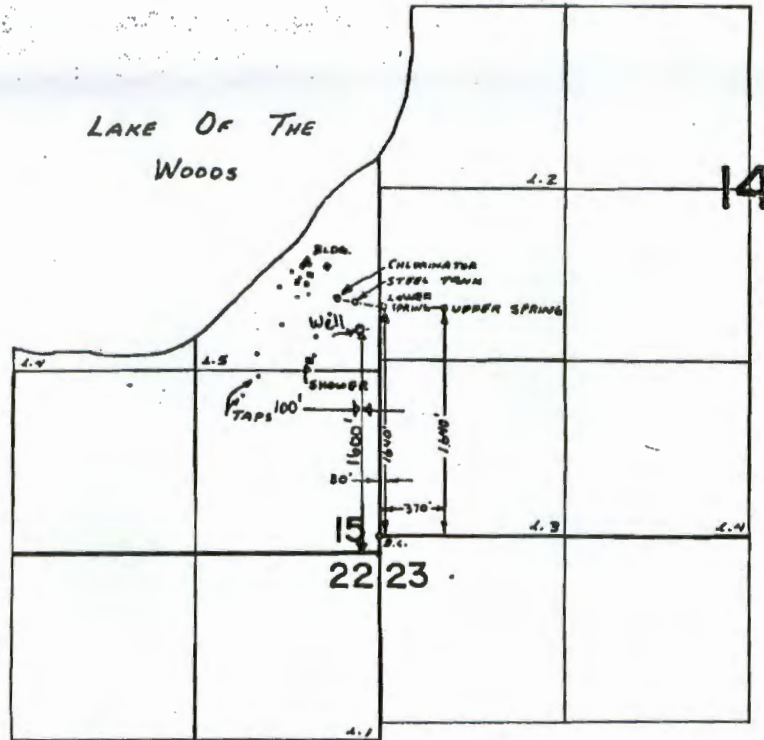

**FINAL PROOF SURVEY
UNDER**

RECEIVED BY OWRD

OCT 13 2015

SALEM, OR

Application No. 43771 Permit No. 32709
IN NAME OF

WINEMA GIRL SCOUT COUNCIL, INC.

Surveyed July 16, 1975, by L. E. Gould WATER RESOURCES DEPT.
SALEM, OREGON

RECEIVED
MAR 14 1978