



Oregon Water Resources Department
 725 Summer Street NE, Suite A
 Salem Oregon 97301-1266
 (503) 986-0900
 www.wrd.state.or.us

Certificate of Water Right Ownership Update

NOTICE TO SELLERS & BUYERS:

By law, all water belongs to the public (ORS 537.110). In almost every instance, a permit or water right certificate from the Water Resources Department is needed before using, diverting or storing water (ORS 537.130). However, most domestic wells do not require water rights. A certificate of water right stays with the land. In order to keep track of water right ownership, the Department requests that this form be submitted to the Department. **If for multiple rights, a separate form for each right will be required.**

Water that has been used for a long time in one place or that involves a water structure (like a dam) that already exists is no guarantee that there is a water right which would allow the water use to continue.

If you have any questions about this form or water right requirements, please contact your local watermaster or call the Water Resources Department at 503-986-0900.

Note: Please type or print legibly when filling in the following information. Use additional paper if necessary.

PROPERTY SELLER INFORMATION

Applicant(s): Russell + Deborah HAS
First Last
 Mailing Address: 93394 Catching Creek Lane
Myrtle Point Oregon 97458
City State Zip
 Phone: _____
Home Work Other

RECEIVED BY OWRD

PROPERTY BUYER INFORMATION

Applicant(s): ROBERT BRIGHT FEB 01 2016
First Last
 Mailing Address: 93394 Catching Creek Lane SALEM, OR
MYRTLE POINT OREGON 97458
City State Zip
 Phone: 541-572-2021 Ø Ø
Home Work Other

PROPERTY DESCRIPTION (attach additional pages if necessary):

County: COOS Township: 29S Range: 12W Section: 30
 Tax Lot Number(s): 700

Street address of water right property: 93394 Catching Creek Lane Myrtle Point, OR 97458

Water Right Information (attach copy of water right permit or certificate & final proof map):

Application #: S-51242 Permit #: 37327 Certificate or Page #: 54453

Will all the lands associated with this water right be owned by the buyer? Yes No

Name of individual completing this form: Robert Lee Bright Phone: 541-572-2021

Signature: Robert Lee Bright Date: January 28, 2016

Please be sure to attach a copy of your property deed or legal description of the property.

STATE OF OREGON

COUNTY OF

COOS

CERTIFICATE OF WATER RIGHT

This is to certify, That **VERAL E. TARNO**

of Catching Creek Rt, Box 10, Myrtle Point, State of Oregon 97458, has made proof to the satisfaction of the Water Resources Director, of a right to the use of the waters of Catching Creek and an unnamed spring

a tributary of South Fork Coquille River for the purpose of irrigation of 46.4 acres and domestic use for one family

under Permit No. 37327 and that said right to the use of said waters has been perfected in accordance with the laws of Oregon; that the priority of the right hereby confirmed dates from September 18, 1973

that the amount of water to which such right is entitled and hereby confirmed, for the purposes aforesaid, is limited to an amount actually beneficially used for said purposes, and shall not exceed 0.435 cubic foot per second, being 0.43 cfs from Catching Creek for irrigation and 0.005 cfs from spring for domestic

or its equivalent in case of rotation, measured at the point of diversion from the stream. The point of diversion is located in the SE 1/4 NE 1/4, NW 1/4 SE 1/4, Section 30, T29S, R12W, WM; Creek- 360 feet North and 530 feet West; Spring- 1240 feet South and 2470 feet West, both from East 1/4 Corner, Section 30.

The amount of water used for irrigation, together with the amount secured under any other right existing for the same lands, shall be limited to one-eightieth of one cubic foot per second per acre, or its equivalent for each acre irrigated and shall be further limited to a diversion of not to exceed 2.5 acre-feet per acre for each acre irrigated during the irrigation season of each year,

and shall conform to such reasonable rotation system as may be ordered by the proper state officer.

A description of the place of use under the right hereby confirmed, and to which such right is appurtenant, is as follows:

Domestic and 4.8 acres SW 1/4 NE 1/4
 22.8 acres SE 1/4 NE 1/4
 8.0 acres NE 1/4 SE 1/4
 10.8 acres NW 1/4 SE 1/4
 Section 30
 Township 29 South, Range 12 West, WM

The right to the use of the water for the purposes aforesaid is restricted to the lands or place of use herein described and is subject to minimum flows established by the Water Resources Commission with an effective date prior to this right.

WITNESS the signature of the Water Resources Director, affixed

this date. June 6, 1986

/s/ William H. Young

Water Resources Director

Recorded in State Record of Water Right Certificates, Volume 49, page 54453


29530/TS
 51242

RECEIVED BY OWRD

FEB 01 2016

SALEM, OR

T. 29S., R. 12W., W.M.

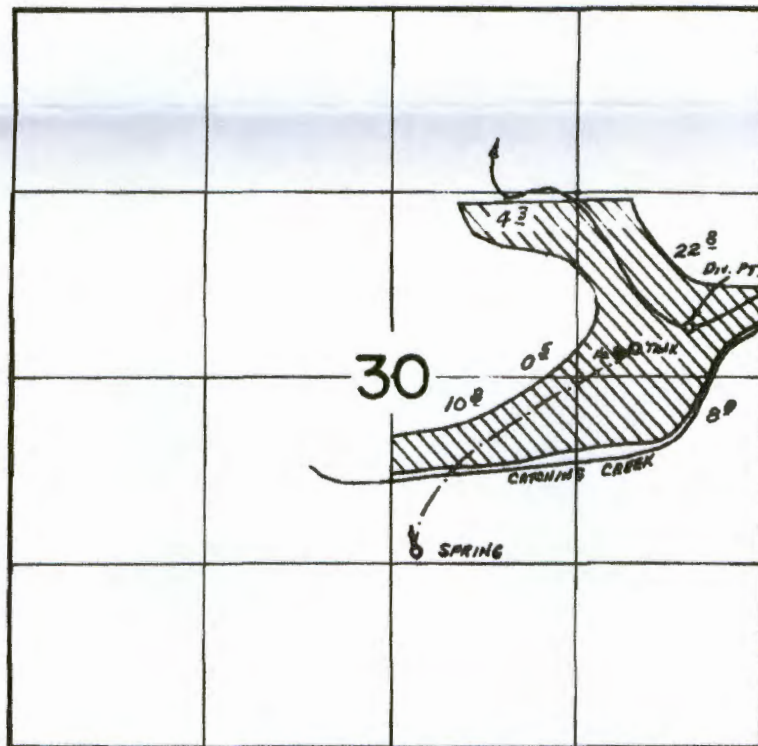

Div. Pts. Loc.: CREEK- 360' N. & 530' W.; SPRING- 1240' S. & 2470' W.,
BOTH FROM E 1/4 COR. SEC. 30.

FINAL PROOF SURVEY
UNDER

Application No. 51242... Permit No. 37327.....
IN NAME OF

.....**VERAL E. TARNO**.....

Surveyed JULY 21... 1980.. by J.S. DONALDSON

RECEIVED BY OWRD
FEB 01 2016
SALEM, OR

F1-Help F2-Edit F3-Form F4-Quick Entry

Date: 73/09/18 Permit: 37327 Appl: 51242 Cert: 54453 No: 1-2
Use: DO Loc : 291230 Source: Spring

Ac : CFS : .005 ResAf: Trib of : SF Coquille River Misc

Filer: Tarno First: Russell Last: Has
Addr : HC 84, Box 2C63
City : Myrtle Point St: Or Zip: 97458

TxLot: 700 Acct#: 11674.00 Ac: 121.95

Ref:

SWR party who initiated:

|||||1|||||2|||||3|||||4|||||5|||||6|||||7|||||8
COOS No previous match. Page 1 of 1
Esc-Cancel F10-Continue

F1-Help F2-Edit F3-Form F4-Quick Entry

Date: 73/09/18 Permit: 37327 Appl: 51242 Cert: 54453 No: 2-2
Use: IR Loc : 291230 Source: Catching

Ac : 46.4 CFS : .430 ResAf: Trib of : SF Coquille River Misc

Filer: Tarno First: Russell Last: Has
Addr : HC 84, Box 2C63
City : Myrtle Point St: Or Zip: 97458

TxLot: 700 Acct#: 11674.00 Ac: 121.95

Ref:

SWR party who initiated:

|||||1|||||2|||||3|||||4|||||5|||||6|||||7|||||8
COOS Review or edit record 567 (match 2). Page 1 of 1
Esc-Cancel F10-Continue

RECEIVED BY OWRD

FEB 01 2016

SALEM, OR