



Oregon Water Resources Department
 725 Summer Street NE, Suite A
 Salem Oregon 97301-1266
 (503) 986-0900
 www.wrd.state.or.us

Certificate of Water Right Ownership Update

NOTICE TO SELLERS & BUYERS:

By law, all water belongs to the public (ORS 537.110). In almost every instance, a permit or water right certificate from the Water Resources Department is needed before using, diverting or storing water (ORS 537.130). However, most domestic wells do not require water rights. A certificate of water right stays with the land. In order to keep track of water right ownership, the Department requests that this form be submitted to the Department. *If for multiple rights, a separate form for each right will be required.*

Water that has been used for a long time in one place or that involves a water structure (like a dam) that already exists is no guarantee that there is a water right which would allow the water use to continue.

If you have any questions about this form or water right requirements, please contact your local watermaster or call the Water Resources Department at 503-986-0900.

Note: Please type or print legibly when filling in the following information. Use additional paper if necessary.

PROPERTY SELLER INFORMATION

Applicant(s): Willamette Industries, Inc.
First Last
 Mailing Address: 1002 Executive Building
Portland Oregon 97204
City State Zip
 Phone: _____
Home Work Other

PROPERTY BUYER INFORMATION

Applicant(s): State of Oregon County of LINN Attn: Russ Williams, Director of General Services
First Last
 Mailing Address: 330 SW 3rd Street
Albany Oregon 97321
City State Zip
 Phone: 541-967-3880 541-990-2051
Home Work Other

PROPERTY DESCRIPTION (attach additional pages if necessary):

County: Linn Township: 13S Range: 1E Section: 29,32
 Tax Lot Number(s): 2200 on assessors map 13S01E29

RECEIVED BY OWRD

Street address of water right property: _____ DEC 14 2015

Water Right Information (attach copy of water right permit or certificate & final proof map):

Application #: R-46151 Permit #: R-5488 Certificate or Page #: 41353 SALEM, OR

Will all the lands associated with this water right be owned by the buyer? Yes No

Name of individual completing this form: J. Edward Henricks (CWRE No. 170) Phone: 541-971-7668

Signature: J. Edward Henricks Date: 12-8-15

Please be sure to attach a copy of your property deed or legal description of the property.

STATE OF OREGON

COUNTY OF LINN

CERTIFICATE OF WATER RIGHT

This Is to Certify, That WILLAMETTE INDUSTRIES INCORPORATED 97204

of 1002 Executive Building, Portland, State of Oregon, has made proof to the satisfaction of the STATE ENGINEER of Oregon, of a right to the use of the waters of South Santiam River, two unnamed streams, and reservoirs constructed under Application No. R-46151, Permit No. R-5488

a tributary of Santiam River for the purpose of maintenance of fire suppression system, condenser and grate cooling, maintaining pond, manufacturing, log deck sprinkling, and steam power plant under Permit No. 34480 of the State Engineer, and that said right to the use of said waters has been perfected in accordance with the laws of Oregon; that the priority of the right hereby confirmed dates from June 29, 1969 for 2.47 cubic feet per second and October 31, 1969 for 0.30 cubic foot per second

that the amount of water to which such right is entitled and hereby confirmed, for the purposes aforesaid, is limited to an amount actually beneficially used for said purposes, and shall not exceed 2.77 cubic feet per second, being 2.47 c.f.s. from South Santiam River, and 0.30 c.f.s. from unnamed streams, being 0.15 c.f.s. from each stream

or its equivalent in case of rotation, measured at the point of diversion from the stream. The point of diversion is located in the NE 1/4 SW 1/4, SW 1/4 SW 1/4, SE 1/4 SW 1/4, Section 29, T. 13 S., R. 1 E., W. M., River - 1520 feet North and 1670 feet East, 1810 feet North and 690 feet East, unnamed streams and reservoirs - 1000 feet North and *

The amount of water used for irrigation, together with the amount secured under any other right existing for the same lands, shall be limited to ----- of one cubic foot per second per acre,

and shall conform to such reasonable rotation system as may be ordered by the proper state officer.

A description of the place of use under the right hereby confirmed, and to which such right is appurtenant, is as follows:

NE 1/4 SW 1/4
SW 1/4 SW 1/4
SE 1/4 SW 1/4
SW 1/4 SE 1/4
Section 29

NE 1/4 NW 1/4
NW 1/4 NW 1/4

Both as projected within Ames DLC 45
Lot 11 (NW 1/4 NW 1/4)
Section 32
T. 13 S., R. 1 E., W. M.

RECEIVED BY OWRD

DEC 14 2015

SALEM, OR

* 1750 feet East, 530 feet North and 1250 feet East, all from SW Corner, Section 29.

The right to the use of the water for the purposes aforesaid is restricted to the lands or place of use herein described.

WITNESS the signature of the State Engineer, affixed


this date. December 20, 1974

Chris L. Wheeler
State Engineer

T. I. S., R. I. E., W. M.

RECEIVED
DEC 13 1974

STATE ENGINEER
SALEM OREGON

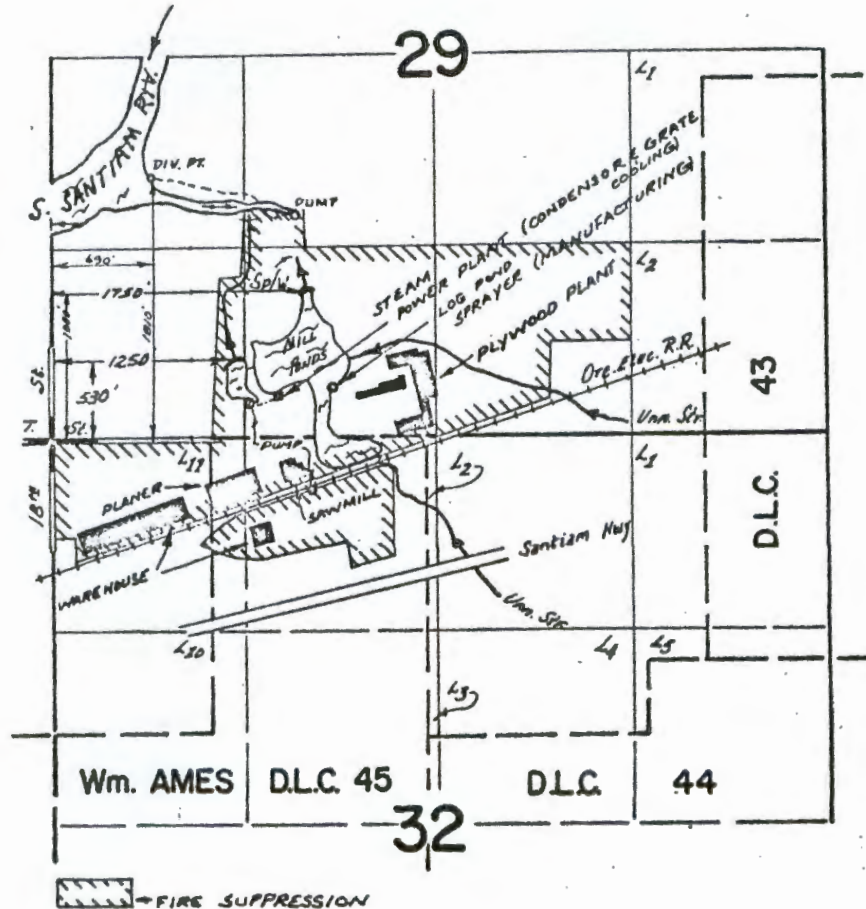

FINAL PROOF SURVEY
UNDER

R-46151 R-5488
Application No. 46152 Permit No. 34480
IN NAME OF

WILLAMETTE INDUSTRIES, INC.

Surveyed 19 Sept. 19 72 by D. Norby
MAY 8 1973 R. MUCKEN
AUG 9 1974 D. NORBY
Oct 14 1974 D. NORBY

RECEIVED BY OWRD

DEC 14 2015

SALEM, OR