




BENTON COUNTY

1"=400'


SCALE 1:8000

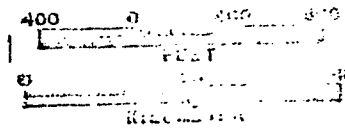

1059

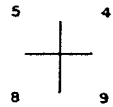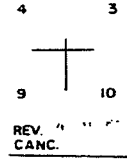

POLK COUNTY

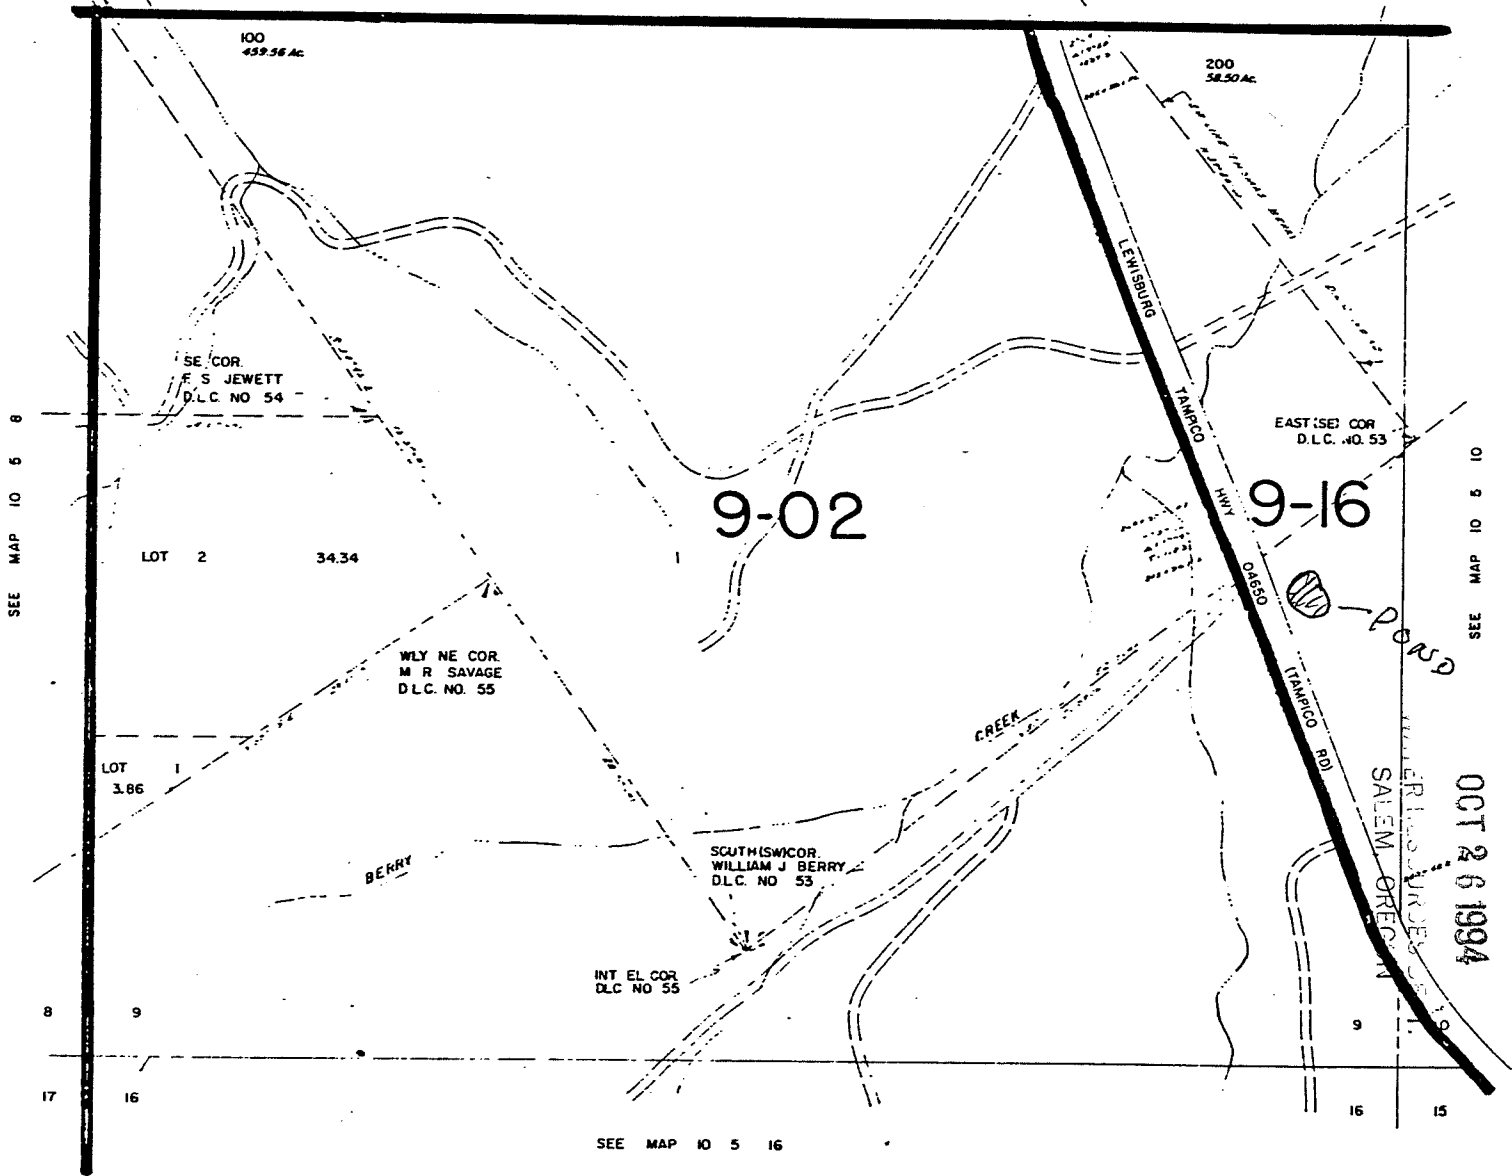

P-74815

RECEIVED

OCT 26 1994