


Application No. P-83128
Permit No.

SECTION 34 T34S R1E WM

SCALE 1" = 400'

34 IE 27

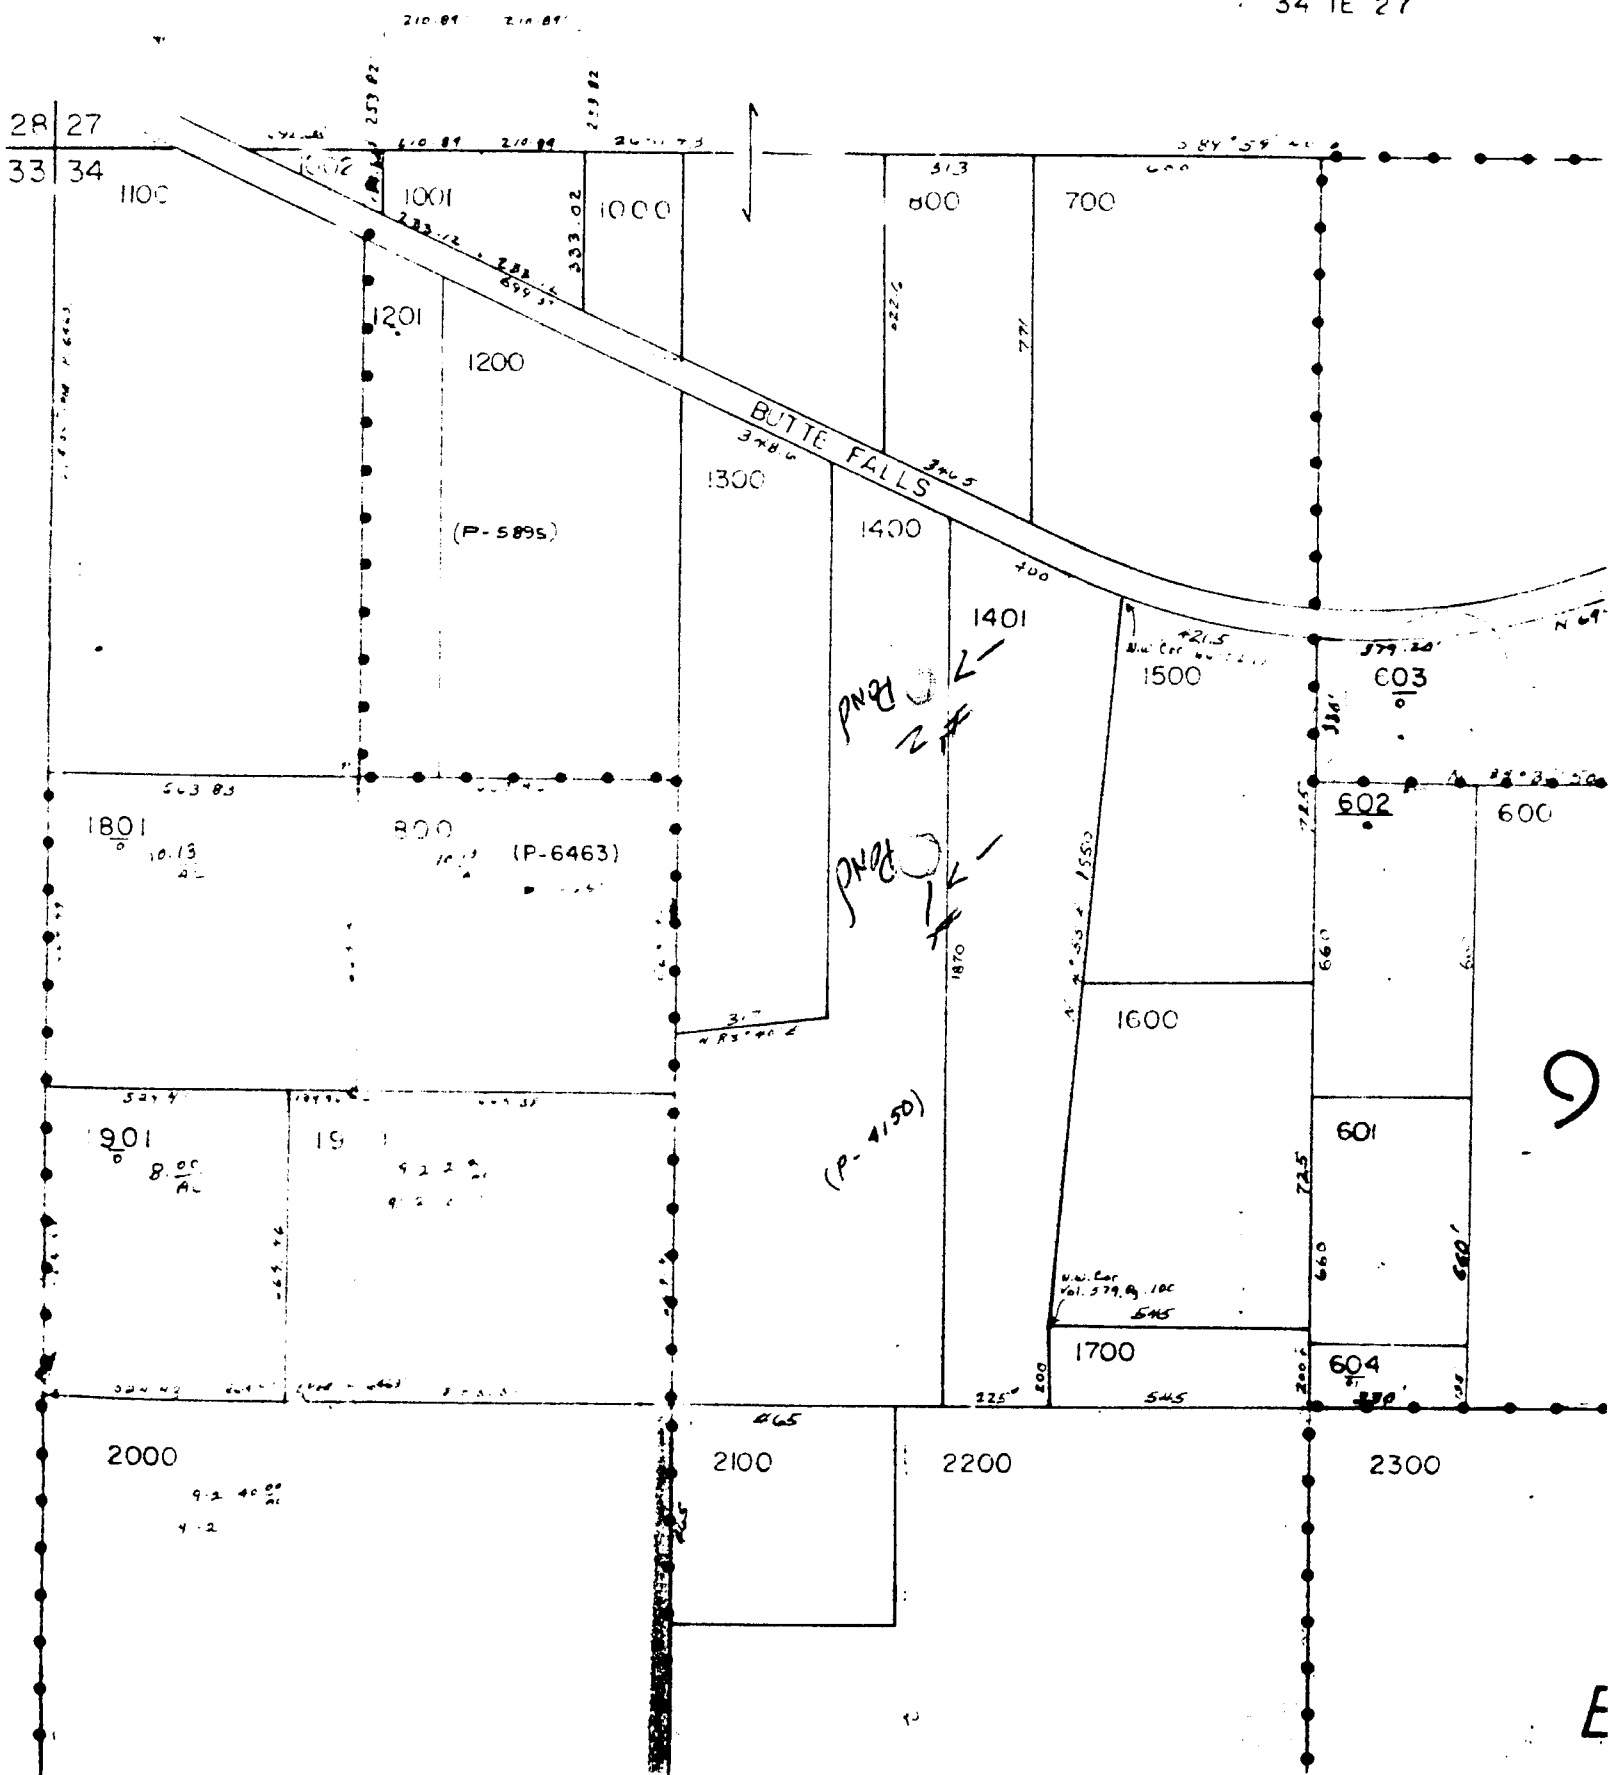

9

E