E WM

1" = 400'

IE 27

IMPORTANT
THIS MAP FOR ASSESSMENT & TAXATION PURPOSES ONLY

34 IE 34

Oct-1991

RECEIVED
DEC 23 1996
WATER RESOURCES DEPT.
SALEM, OREGON

Application No. P-81782
Permit No.
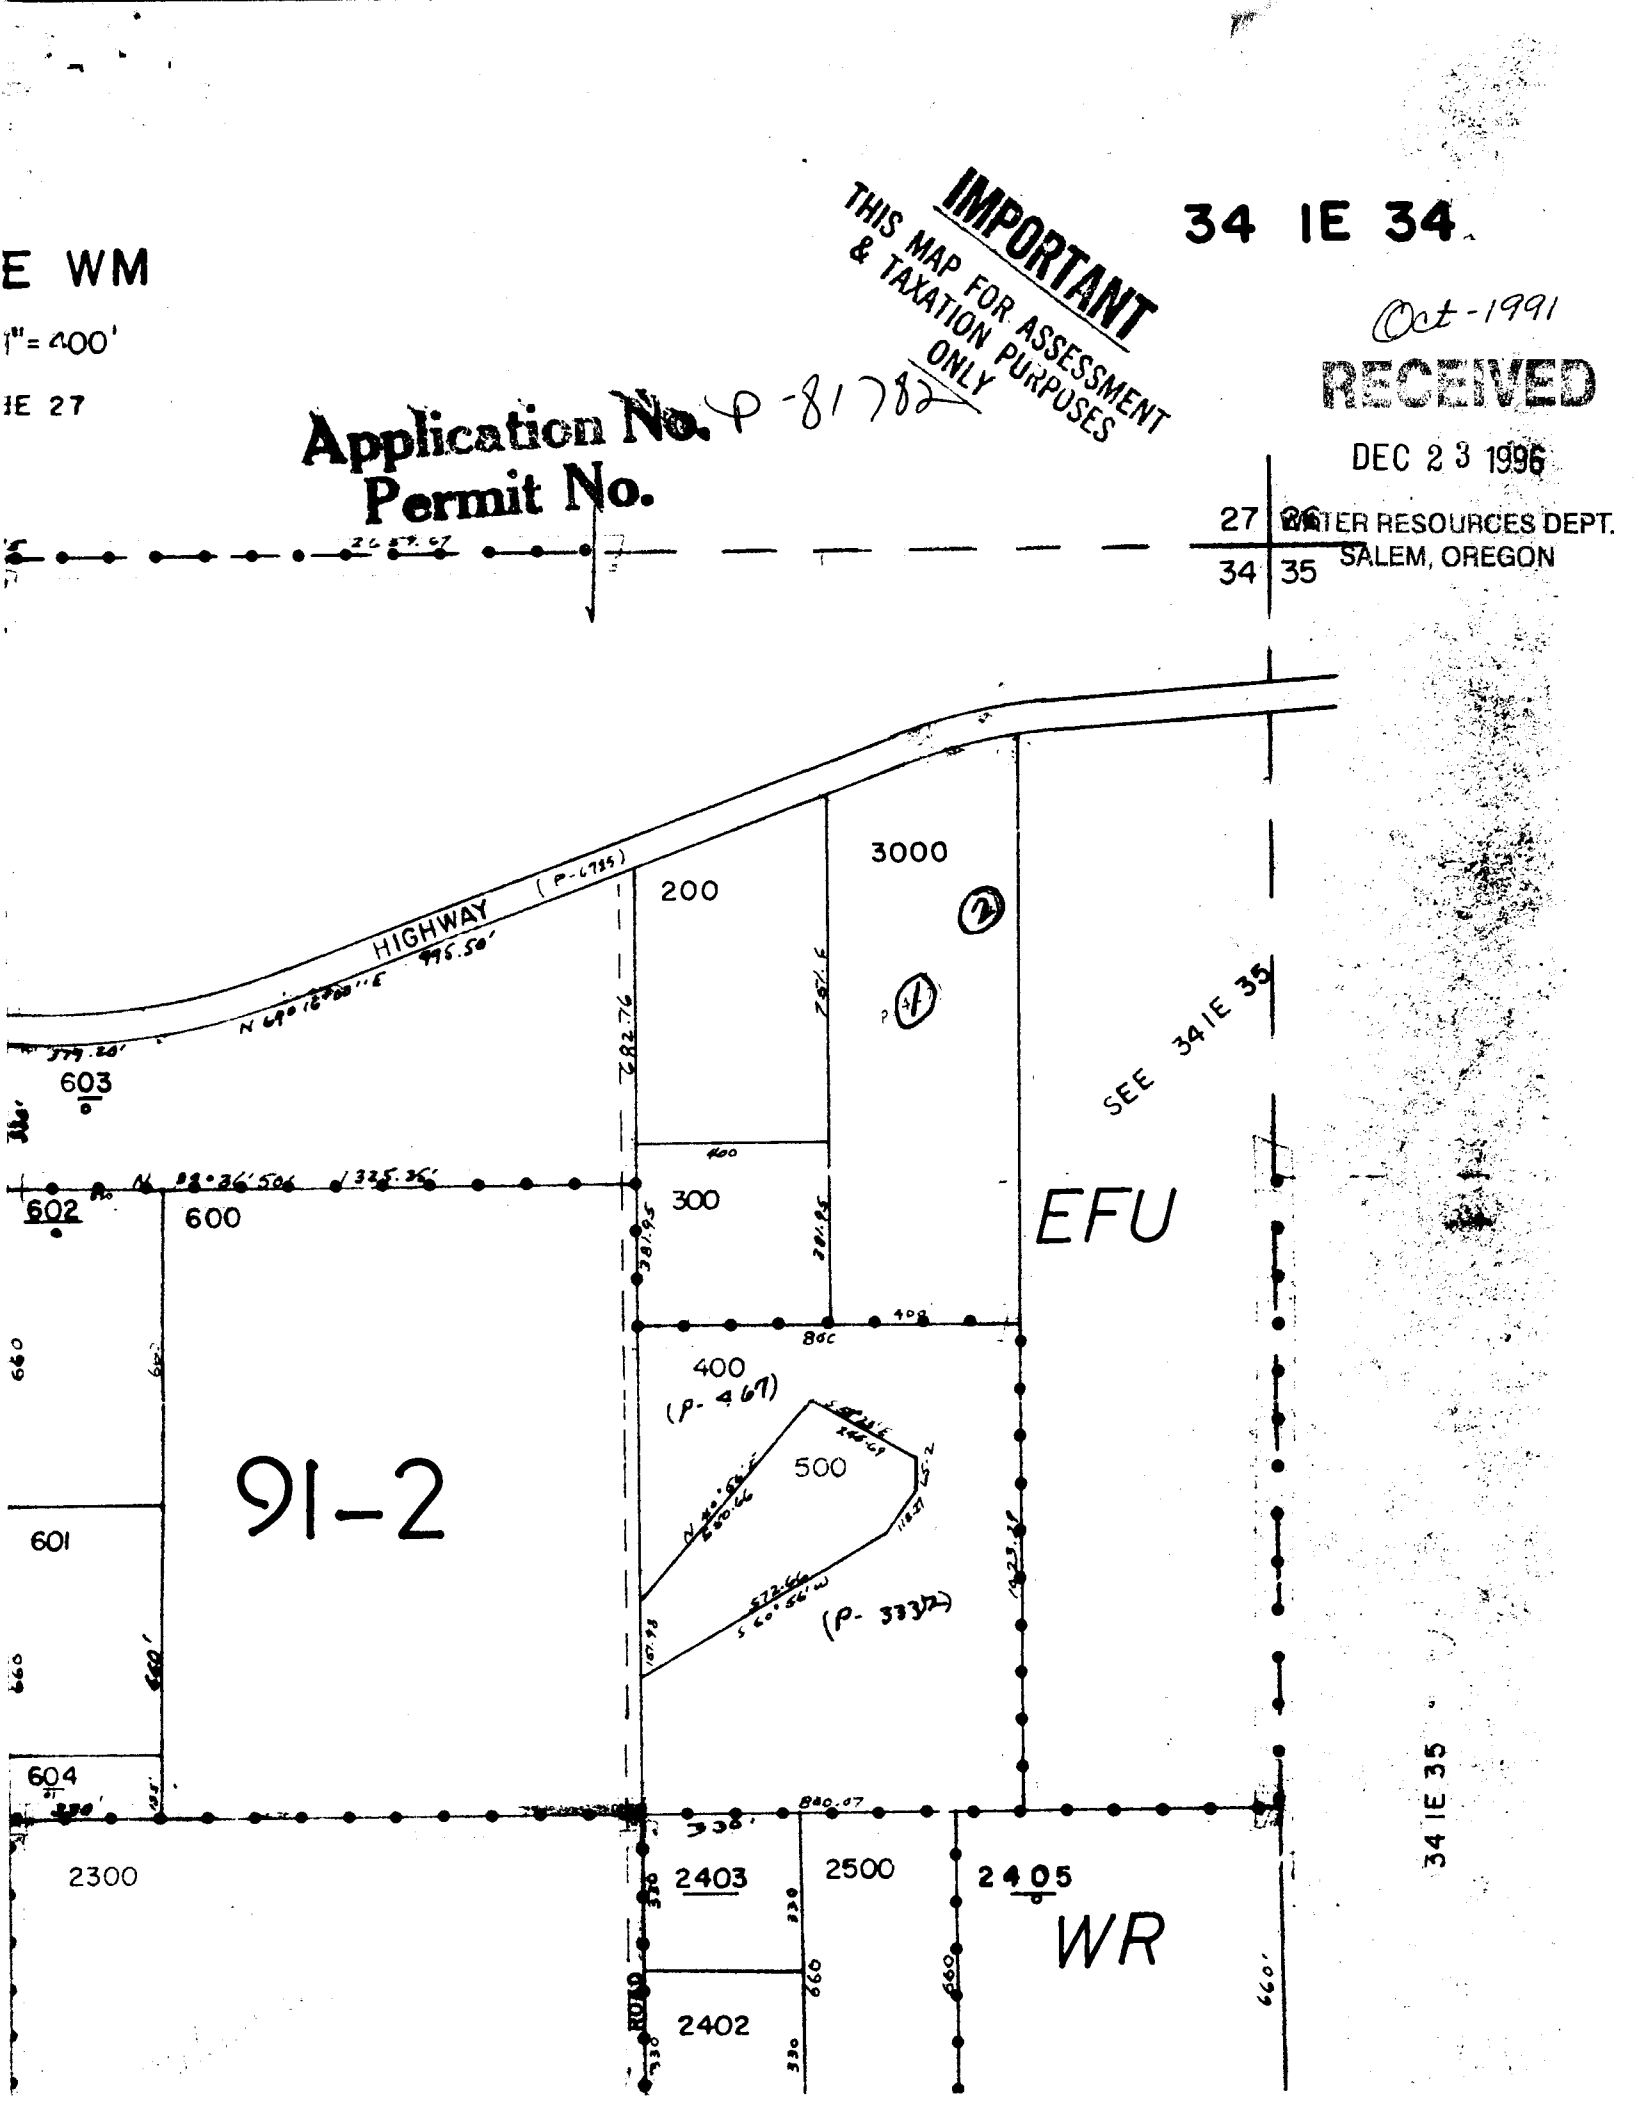
27 | 26
34 | 35