

OREGON WATER RESOURCES DEPARTMENT
WATER RIGHT OWNERSHIP UPDATE FORM

NOTICE TO SELLERS & BUYERS:

By law all water belongs to the public (ORS 537.110). In almost every instance, a permit ("water right") from the Water Resources Department is needed before using, diverting, or storing any water (ORS 537.130). However, most domestic wells do not require water rights. A water right stays with the land. In order to keep track of water right ownership, ORS 537.330 requires persons selling property that has a water right to: 1) provide evidence of the water right to the buyer and 2) notify the Water Resources Department of the water right involved with the real estate transaction. Sellers are exempted from this requirement if the water uses are served by a water district or a city.

Water that has been used for a long time in one place or that involves a water structure (like a dam) that already exists is no guarantee that there is a water right which would allow the water use to continue.

If you have any questions about this form or water right requirements, please contact your local watermaster or call the Water Resources Department at (503)378-8455.

... Note: Please type or print legibly when filling in the following information. Use additional paper if necessary.

PROPERTY SELLER INFORMATION:

Name: JACA BROS., INC., AN OREGON CORPORATION C/O ELIAS JACA, PRESIDENT
Street Address: 817 BLAINE AVE.
City: NAMPA State: ID Zip: 83651
Phone: _____

PROPERTY BUYER INFORMATION:

Name: ROY HALL AND BEA MARIE HALL (COPIES OF 2 RECORDED DEEDS ATTACHED)
Street Address: P.O. BOX 299
City: JORDAN VALLEY State: OR Zip: 97910
Phone: _____

PROPERTY DESCRIPTION (attach additional pages if necessary):

County: MALHEUR Township: _____ Range: _____ Section: _____

Tax Lot number(s): _____

Meets & bounds description (or attach copy of property deed & tax lot map with the parcels highlighted):

SEE COPIES OF LEGAL DESCRIPTION AND MAPS ATTACHED

WATER RIGHT INFORMATION (attach copy of water right certificate or permit & final proof map if available):

Application #: _____ COPIES OF ALL CERTIFICATE ATTACHED
Permit / Certificate / _____

Will all lands associated with the water right be owned by the buyer? Yes No

Name of individual completing this form: SHARON L. MILES Phone: 1-541-889-7625

Signature: *Sharon L. Miles* Date: 11-15-02

RECEIVED

FEB 18 2003

WATER RESOURCES DEPT.
SALEM, OREGON

STATE OF OREGON

COUNTY OF

MALHEUR

CERTIFICATE OF WATER RIGHT

This Is to Certify, That JACA BROTHERS

of Jordan Valley, State of Oregon, 97910, has made proof to the satisfaction of the Water Resources Director, of a right to the use of the waters of a well

a tributary of Sheep Springs Creek for the purpose of irrigation of 108.8 acres

under Permit No. G-3450 and that said right to the use of said waters has been perfected in accordance with the laws of Oregon; that the priority of the right hereby confirmed dates from September 21, 1966

that the amount of water to which such right is entitled and hereby confirmed, for the purposes aforesaid, is limited to an amount actually beneficially used for said purposes, and shall not exceed 1.36 cubic feet per second

or its equivalent in case of rotation, measured at the point of diversion from the stream. The point of diversion is located in the SE $\frac{1}{4}$ SE $\frac{1}{4}$, Section 15, T. 30 S., R. 46 E., W. M., 300 feet North and 140 feet West from the SE corner of Section 15.

The amount of water used for irrigation, together with the amount secured under any other right existing for the same lands, shall be limited to one-eightieth of one cubic foot per second per acre, or its equivalent for each acre irrigated and shall be further limited to a diversion of not to exceed 3 acre feet per acre for each acre irrigated during the irrigation season of each year,

and shall conform to such reasonable rotation system as may be ordered by the proper state officer.

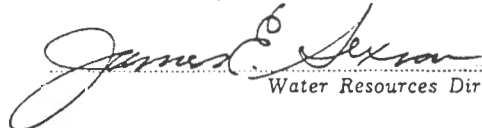
A description of the place of use under the right hereby confirmed, and to which such right is appurtenant, is as follows:

1.6 acres NE $\frac{1}{4}$ NE $\frac{1}{4}$
 3.4 acres NW $\frac{1}{4}$ NE $\frac{1}{4}$
 3.2 acres SW $\frac{1}{4}$ NE $\frac{1}{4}$
 22.4 acres SE $\frac{1}{4}$ NE $\frac{1}{4}$
 37.6 acres NE $\frac{1}{4}$ SE $\frac{1}{4}$
 6.0 acres NW $\frac{1}{4}$ SE $\frac{1}{4}$
 4.2 acres SW $\frac{1}{4}$ SE $\frac{1}{4}$
 30.4 acres SE $\frac{1}{4}$ SE $\frac{1}{4}$
 Section 15
 T. 30 S., R. 46 E., W. M.

The right to the use of the water for the purposes aforesaid is restricted to the lands or place of use herein described, and is subject to the existing minimum flow policies established by the Water Policy Review Board.

WITNESS the signature of the Water Resources Director, affixed

this date. April 12, 1978

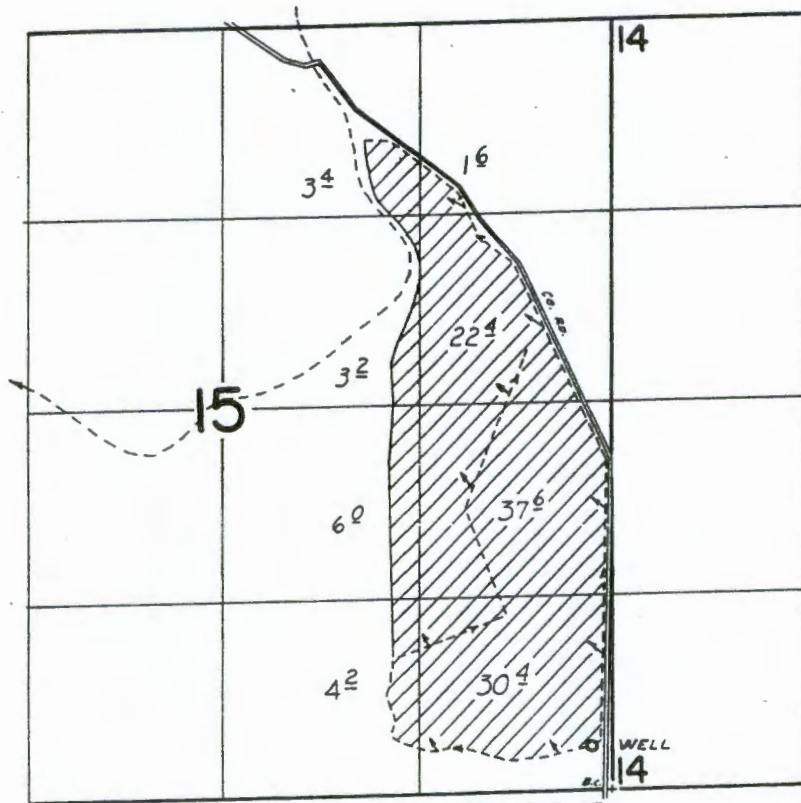

 Water Resources Director

RECEIVED

FEB 18 2003

WATER RESOURCES DEPT.
 SALEM, OREGON

T.30S., R.46E., W.M.



WELL LOC: 300' N & 140' W FROM SE COR. SEC. 15

FINAL PROOF SURVEY
UNDER

Application No. G-3676 Permit No. G-3450
IN NAME OF

JACA BROTHERS

Surveyed July 17 1975, by D. Norby

RECEIVED

FEB 18 2003

WATER RESOURCES DEPT.
SALEM, OREGON