

OREGON WATER RESOURCES DEPARTMENT
WATER RIGHT OWNERSHIP UPDATE FORM

NOTICE TO SELLERS & BUYERS:

By law all water belongs to the public (ORS 537.110). In almost every instance, a permit ("water right") from the Water Resources Department is needed before using, diverting, or storing any water (ORS 537.130). However, most domestic wells do not require water rights. A water right stays with the land. In order to keep track of water right ownership, ORS 537.330 requires persons selling property that has a water right to: 1) provide evidence of the water right to the buyer and 2) notify the Water Resources Department of the water right involved with the real estate transaction. Sellers are exempted from this requirement if the water uses are served by a water district or a city.

Water that has been used for a long time in one place or that involves a water structure (like a dam) that already exists is no guarantee that there is a water right which would allow the water use to continue.

If you have any questions about this form or water right requirements, please contact your local watermaster or call the Water Resources Department at (503)378-8455.

... Note: Please type or print legibly when filling in the following information. Use additional paper if necessary.

PROPERTY SELLER INFORMATION:

Name: JACA BROS., INC., AN OREGON CORPORATION C/O ELIAS JACA, PRESIDENT
Street Address: 817 BLAINE AVE.
City: NAMPA State: ID Zip: 83651
Phone: _____

PROPERTY BUYER INFORMATION:

Name: ROY HALL AND BEA MARIE HALL (COPIES OF 2 RECORDED DEEDS ATTACHED)
Street Address: P.O. BOX 299
City: JORDAN VALLEY State: OR Zip: 97910
Phone: _____

PROPERTY DESCRIPTION (attach additional pages if necessary):

County: MAHEUR Township: _____ Range: _____ Section: _____
Tax Lot number(s): _____
Meets & bounds description (or attach copy of property deed & tax lot map with the parcels highlighted):

SEE COPIES OF LEGAL DESCRIPTION AND MAPS ATTACHED

WATER RIGHT INFORMATION (attach copy of water right certificate or permit & final proof map if available):

Application #: _____ COPIES OF ALL CERTIFICATE ATTACHED
Permit # _____ Certificate # _____
Will all lands associated with the water right be owned by the buyer? Yes ☐ No ☐


Name of individual completing this form: SHARON L. MILES Phone: 1-541-889-7625
Signature: [Signature] Date: 11-15-02

RECEIVED

FEB 18 2003

WATER RESOURCES DEPT.
SALEM, OREGON

T. 32&33 S.R. 45 E.W.M.

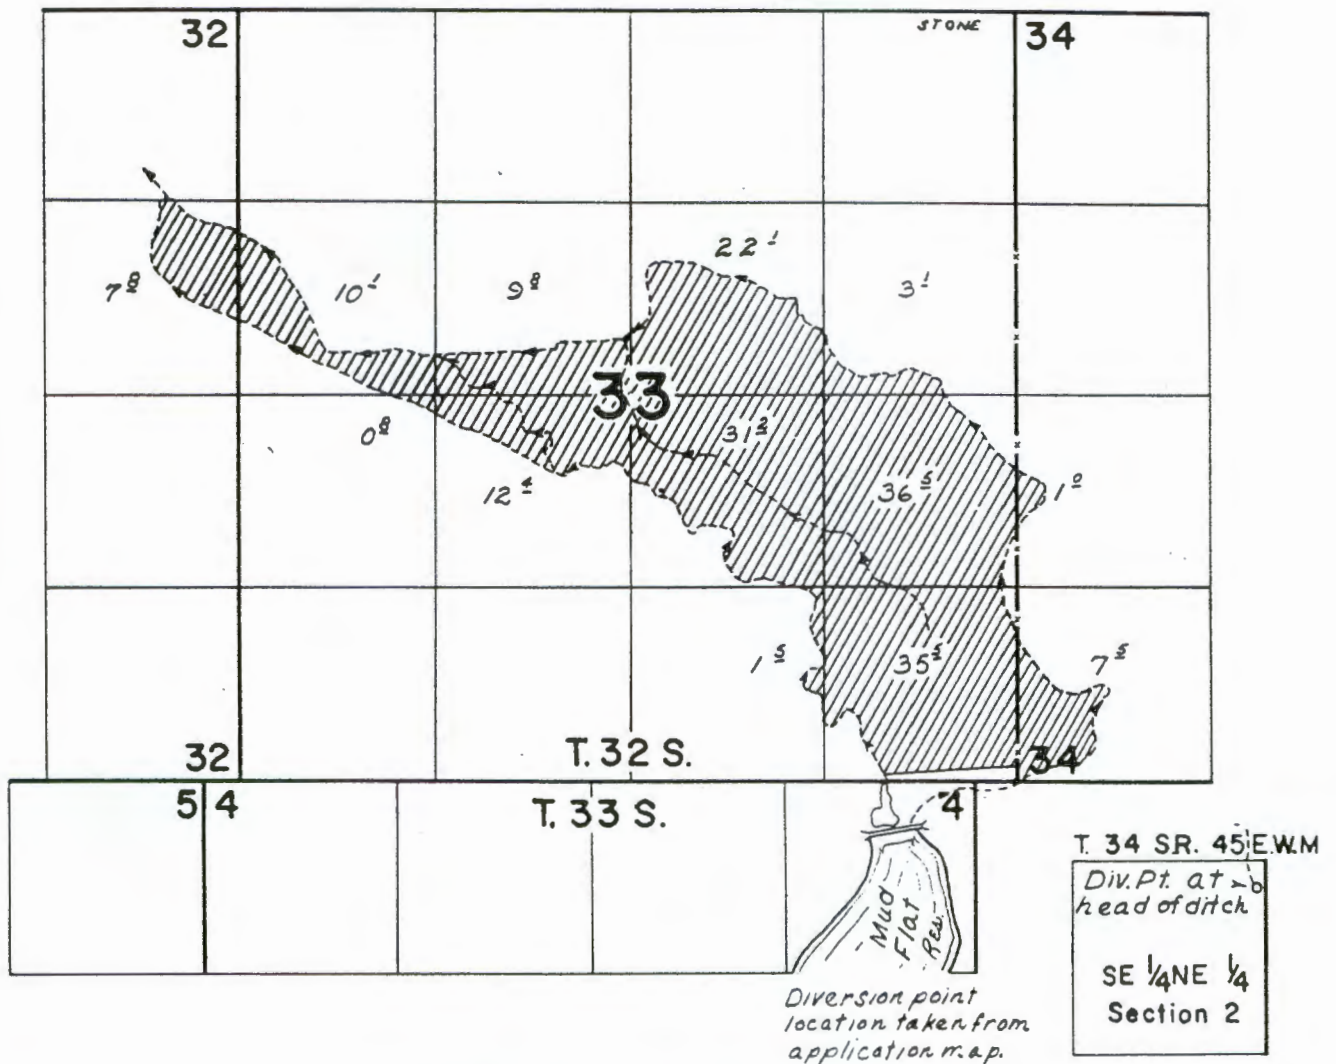

FINAL PROOF SURVEY UNDER

R-30890 R-1947
Application No. 30892 Permit No. 24536
IN NAME OF

JOAQUIN & FELIX JACA

Surveyed July 17 1962, by C.R. Baker

RECEIVED

FEB 18 2003

WATER RESOURCES DEPT.
SALEM, OREGON